


T. 28 S. R. 11 W. W.M.

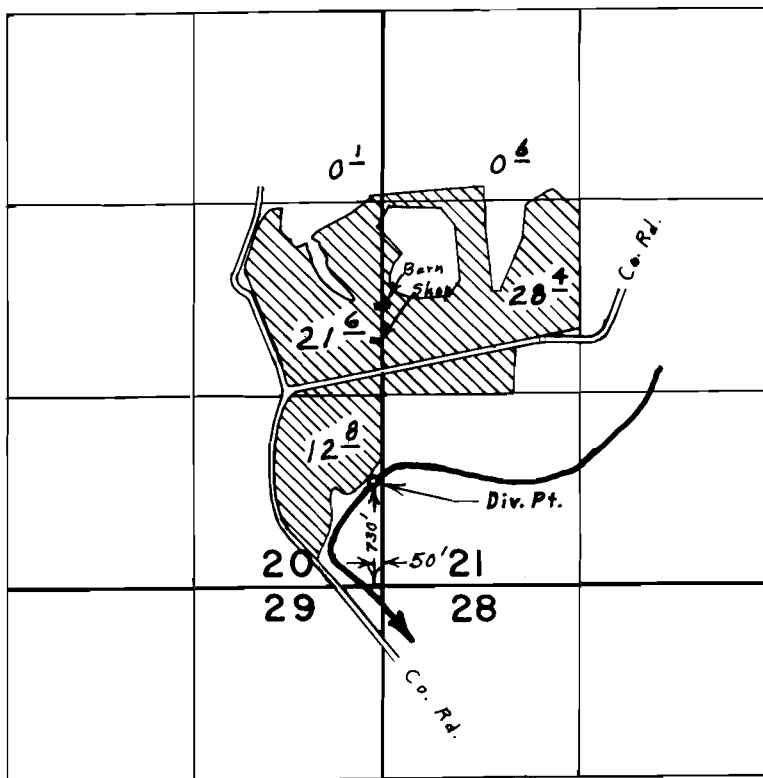

FINAL PROOF SURVEY UNDER

Application No. 41876. Permit No. 31330.
IN NAME OF

R. M. & B. P. HERMES

Surveyed Oct. 24, 1975, by L. E. Gould