


# T.22S.R.5W.W.M.

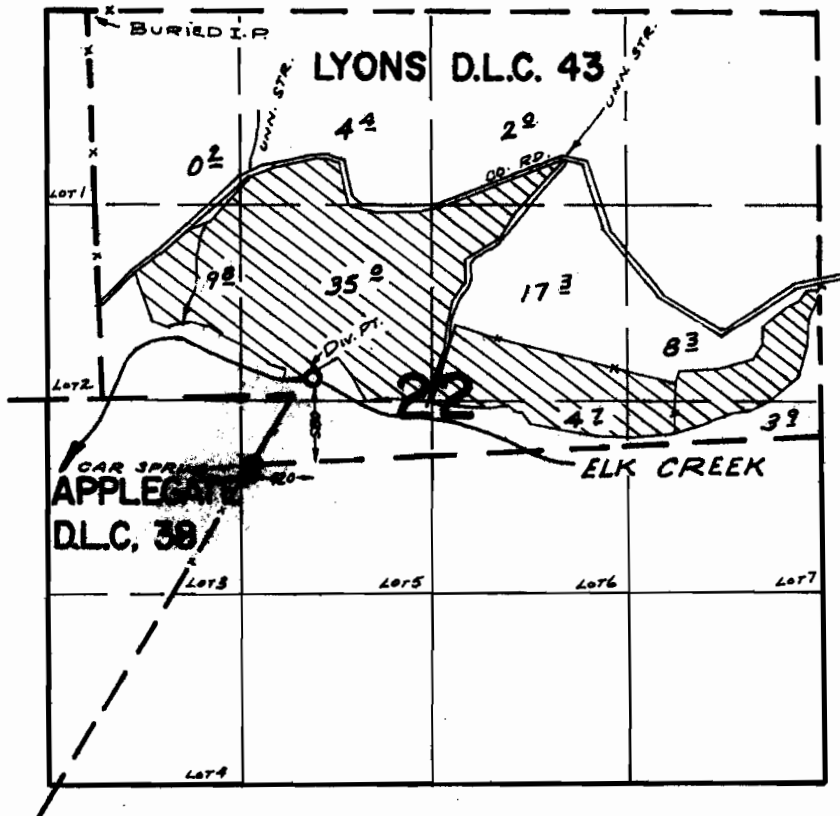

## FINAL PROOF SURVEY

UNDER

Application No. 40310 Permit No. 30066

IN NAME OF

John L. Bell & Charles A. Bass

Surveyed JUNE 17, 1970, by R. MUCKEN