


T. 23 S. R. 31 & 32 E. W.M.

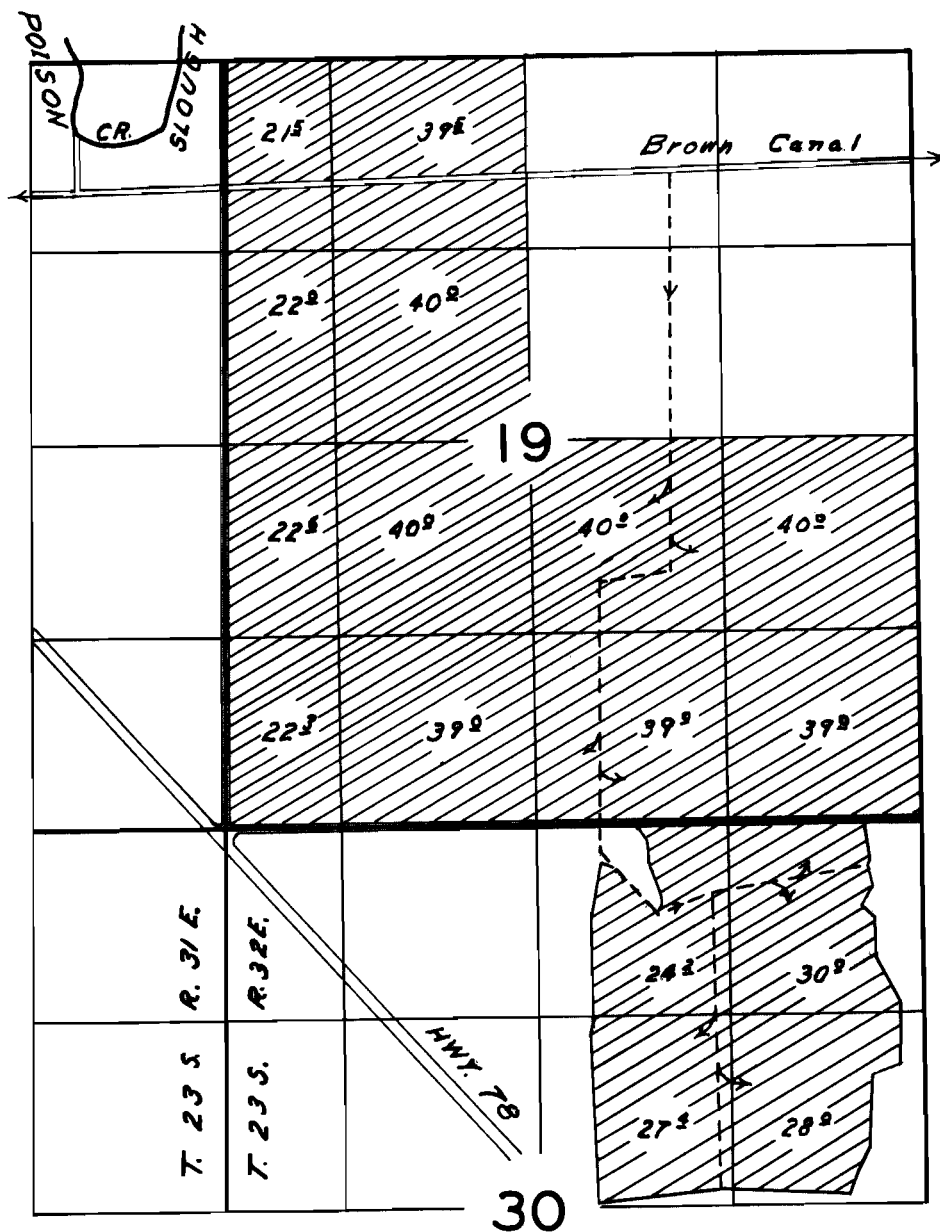

FINAL PROOF SURVEY
UNDER

Application No. 28148 Permit No. 22436
IN NAME OF

Charles B. Cawfield

Surveyed July 21 1958, by W.N. Perry