


OCHOCO NATIONAL FOREST
SNOW MOUNTAIN DISTRICT
scale 4" = 1 mile

T20S R25E W.M.

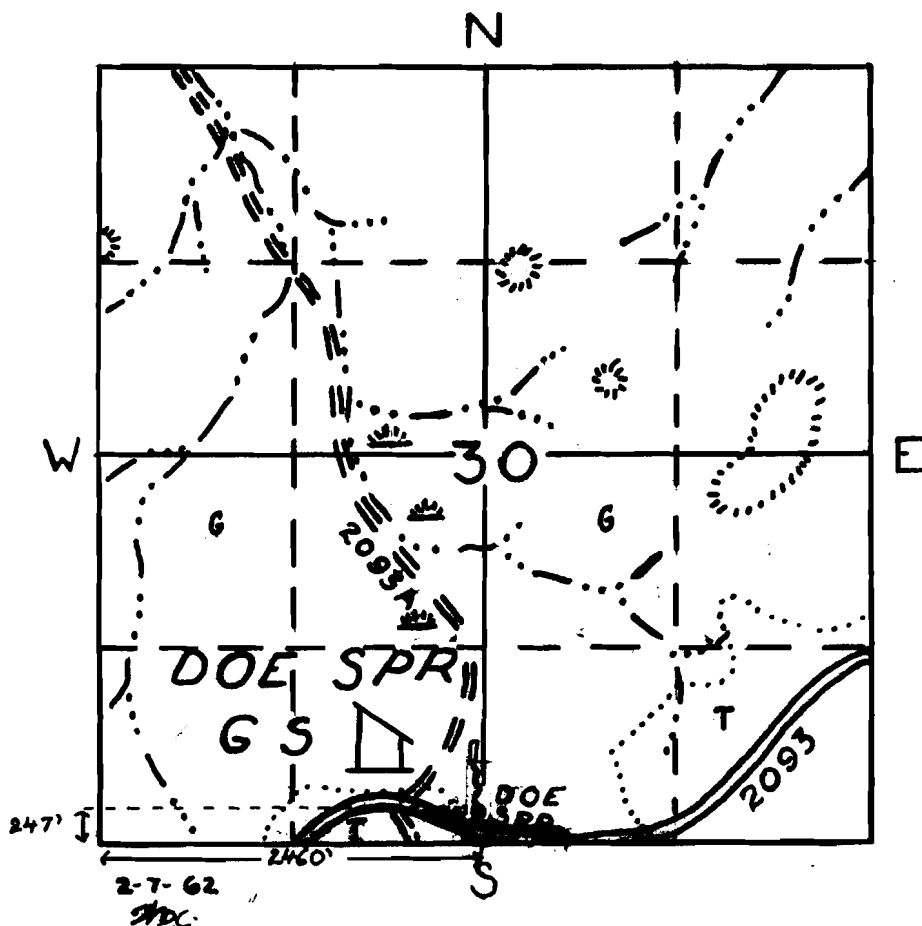

LEGEND

Application No. 37544
Permit No. 28031

Permit No. 28031

TYPE LINE :'''\.\.\.''

G = GRASS

T = TIMBER

== = MAIN RD.

== SECONDARY RD.

 = MEADOW

~...~ INTERMITTENT STR.

on SPRING

= WATER TROUGH

28031