


T.35S. R.IW. W.M.

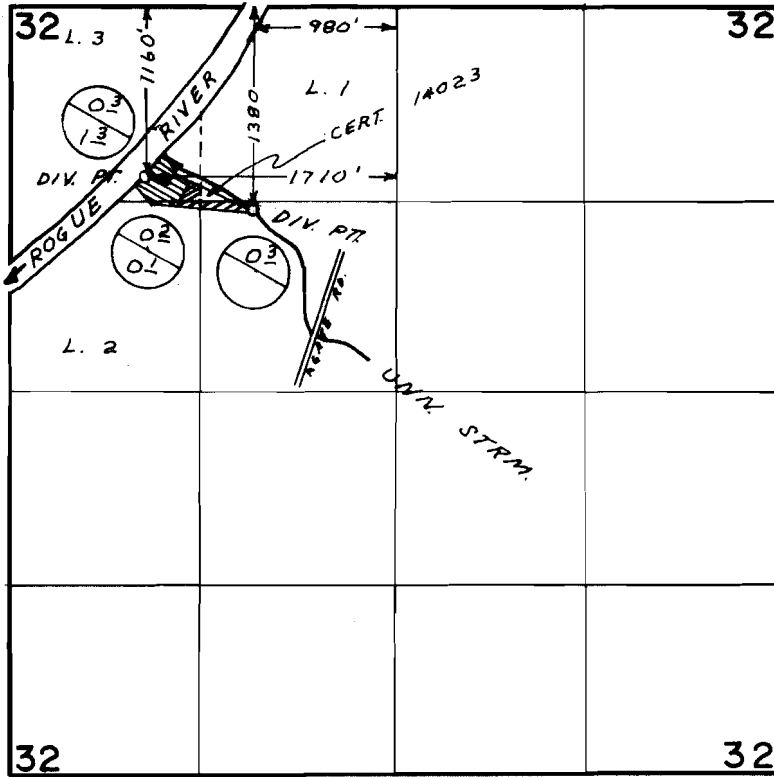

FINAL PROOF SURVEY UNDER

Application No. 43161 Permit No. 32241
42028 Permit No. 31449
 IN NAME OF

RICHARD E. LAWYER

Surveyed APR. 25 1975, by LH NUNN