


T. 34 S. R. 2 W. W.M.

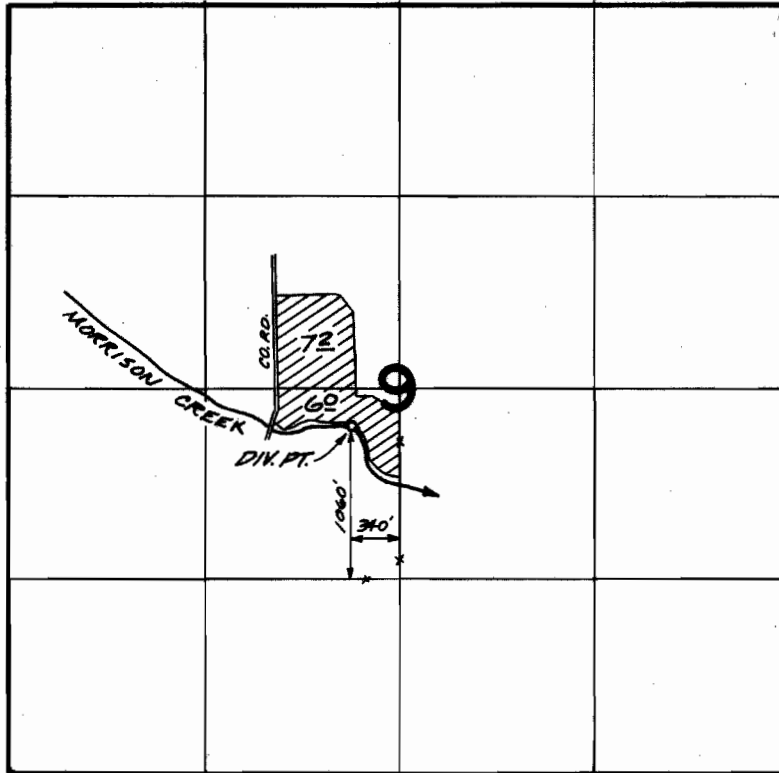

FINAL PROOF SURVEY
UNDER

Application No. 47065 Permit No. 35200
IN NAME OF

GLENN E. ELLIS

Surveyed JULY 31 1974, by D. NORBY