


RECEIVED

FEB 24 1979

WM. DIST. 14
GRANTS PASS, ORE

T. 35 S., R. 7 W., W. M.

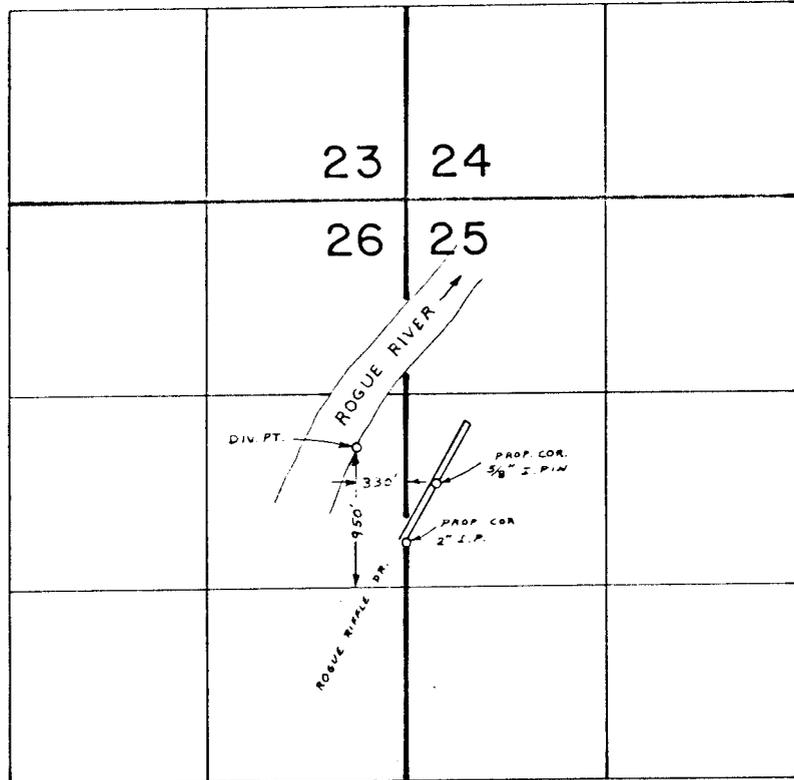

FINAL PROOF SURVEY
UNDER

Transfer No. 3402
Application No. Permit No.
IN NAME OF

HAROLD CLOUSE

Surveyed OCT. 10 78 by B. SUND
19.....