


T.41S.,R.21E.,W.M.

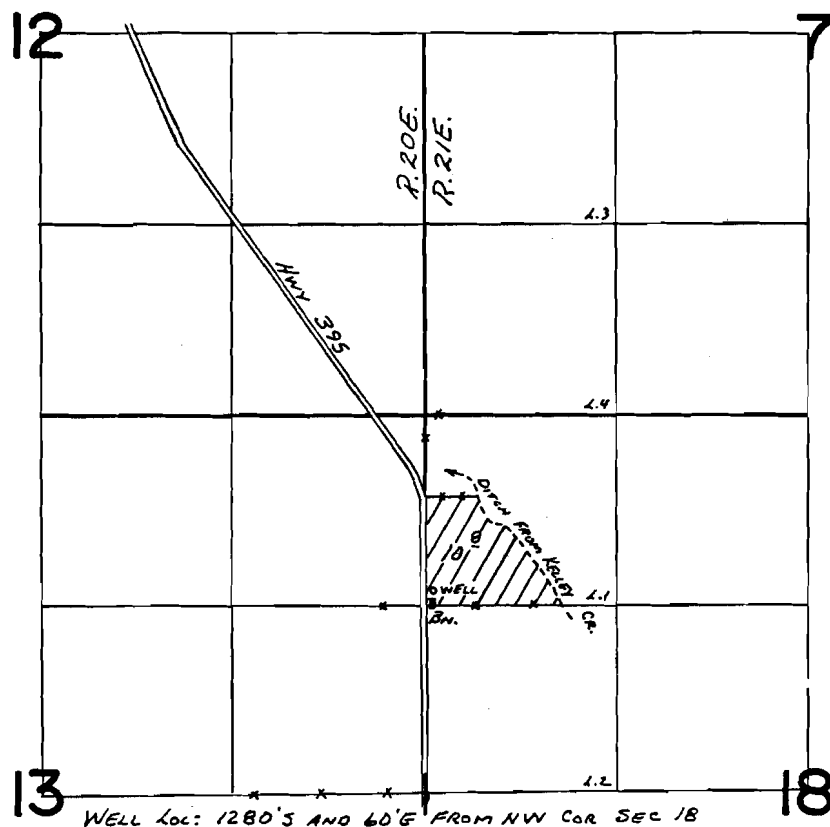

FINAL PROOF SURVEY
UNDER

Application No. G-5465 Permit No. G-5375
IN NAME OF

JACK HINTON

Surveyed Oct. 15, 1975, by L. Tell