


T.39S. R.22E. W.M.

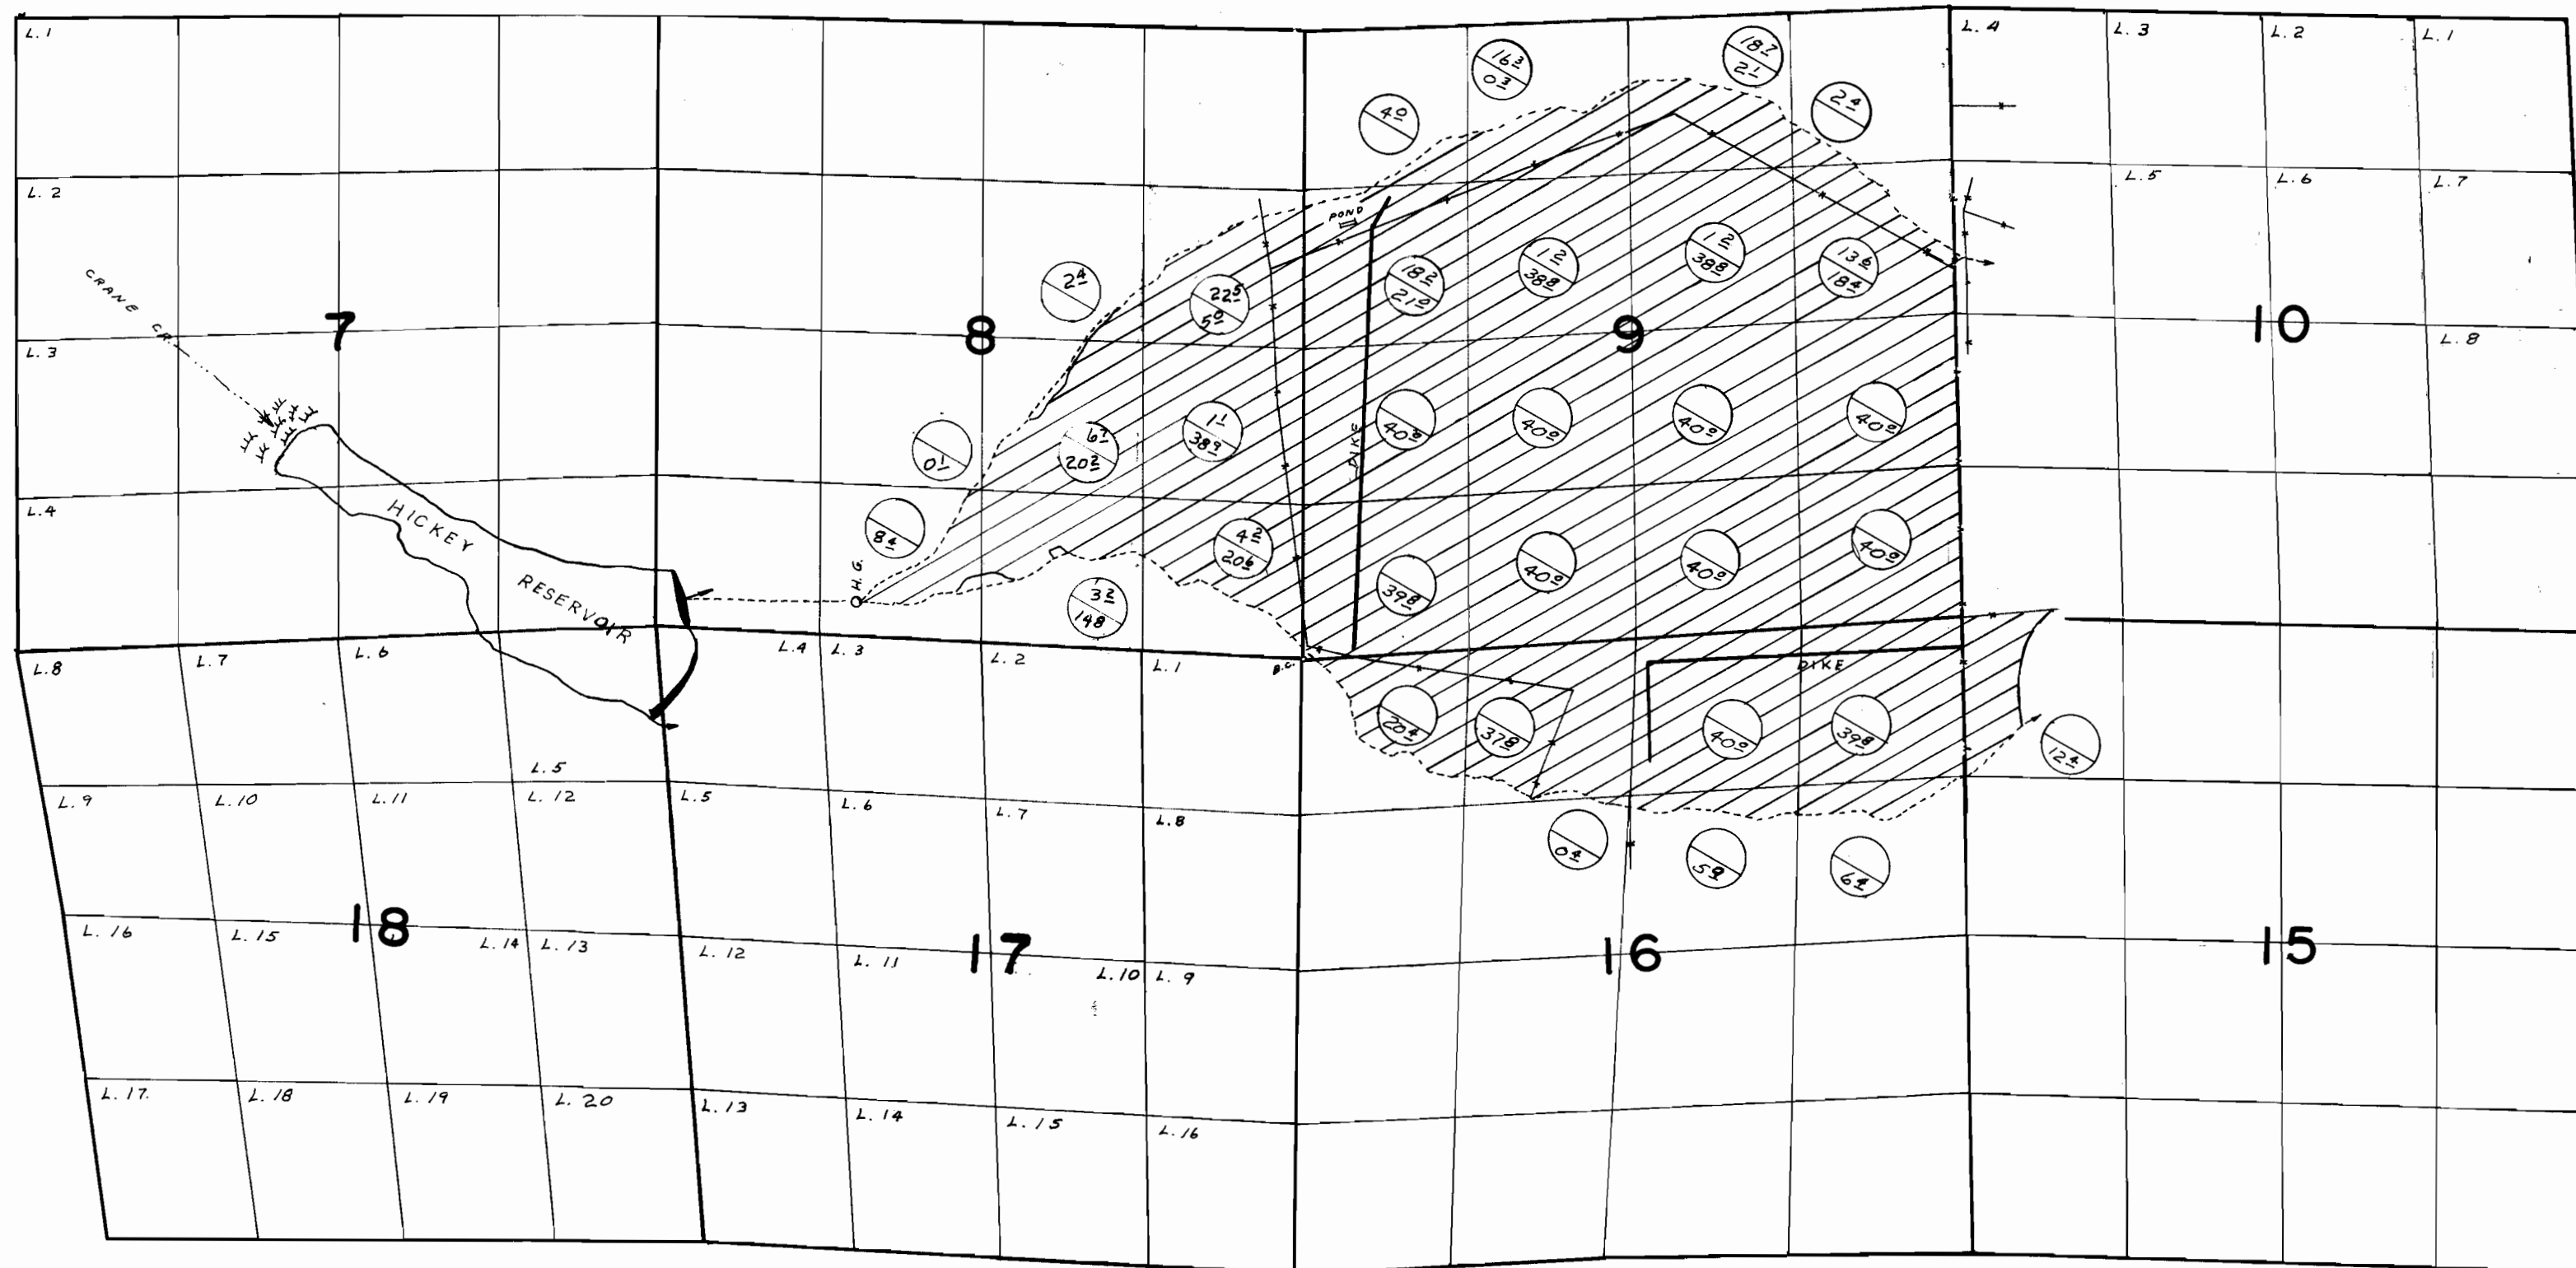

DIV. PT. LOC. 520' N & 5170' W FROM SE COR. SEC. 8

CERT. 9430 PERMIT 32602
ACRES IRRIGATED

FINAL PROOF SURVEY UNDER

R-42327 R-5011
APPLICATION NO. 42328 PERMIT NO. 32602
IN NAME OF

WILLIAM A. HICKEY

SURVEYED JUL 17, 1975, BY L.H. NUNN