


T.16S. R.7W. W.M.

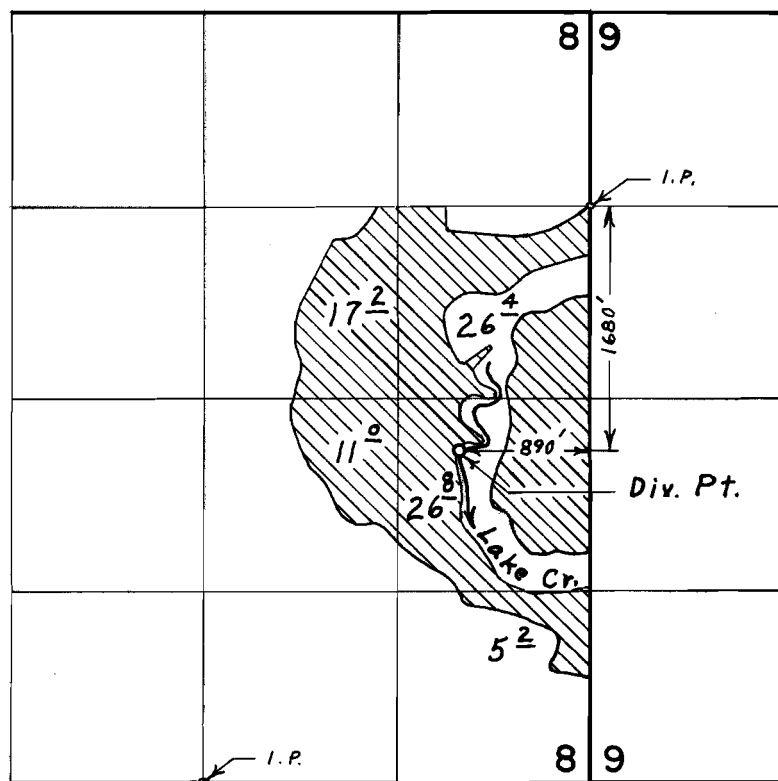

FINAL PROOF SURVEY
UNDER

Application No. 44518 Permit No. 33313
IN NAME OF

DANIEL & ANN KLEMP

Surveyed Nov. 5, 1975, by L. E. Gould