


RECEIVED

MAR 15 1974


STATE ENGINEER
SALEM, OREGON

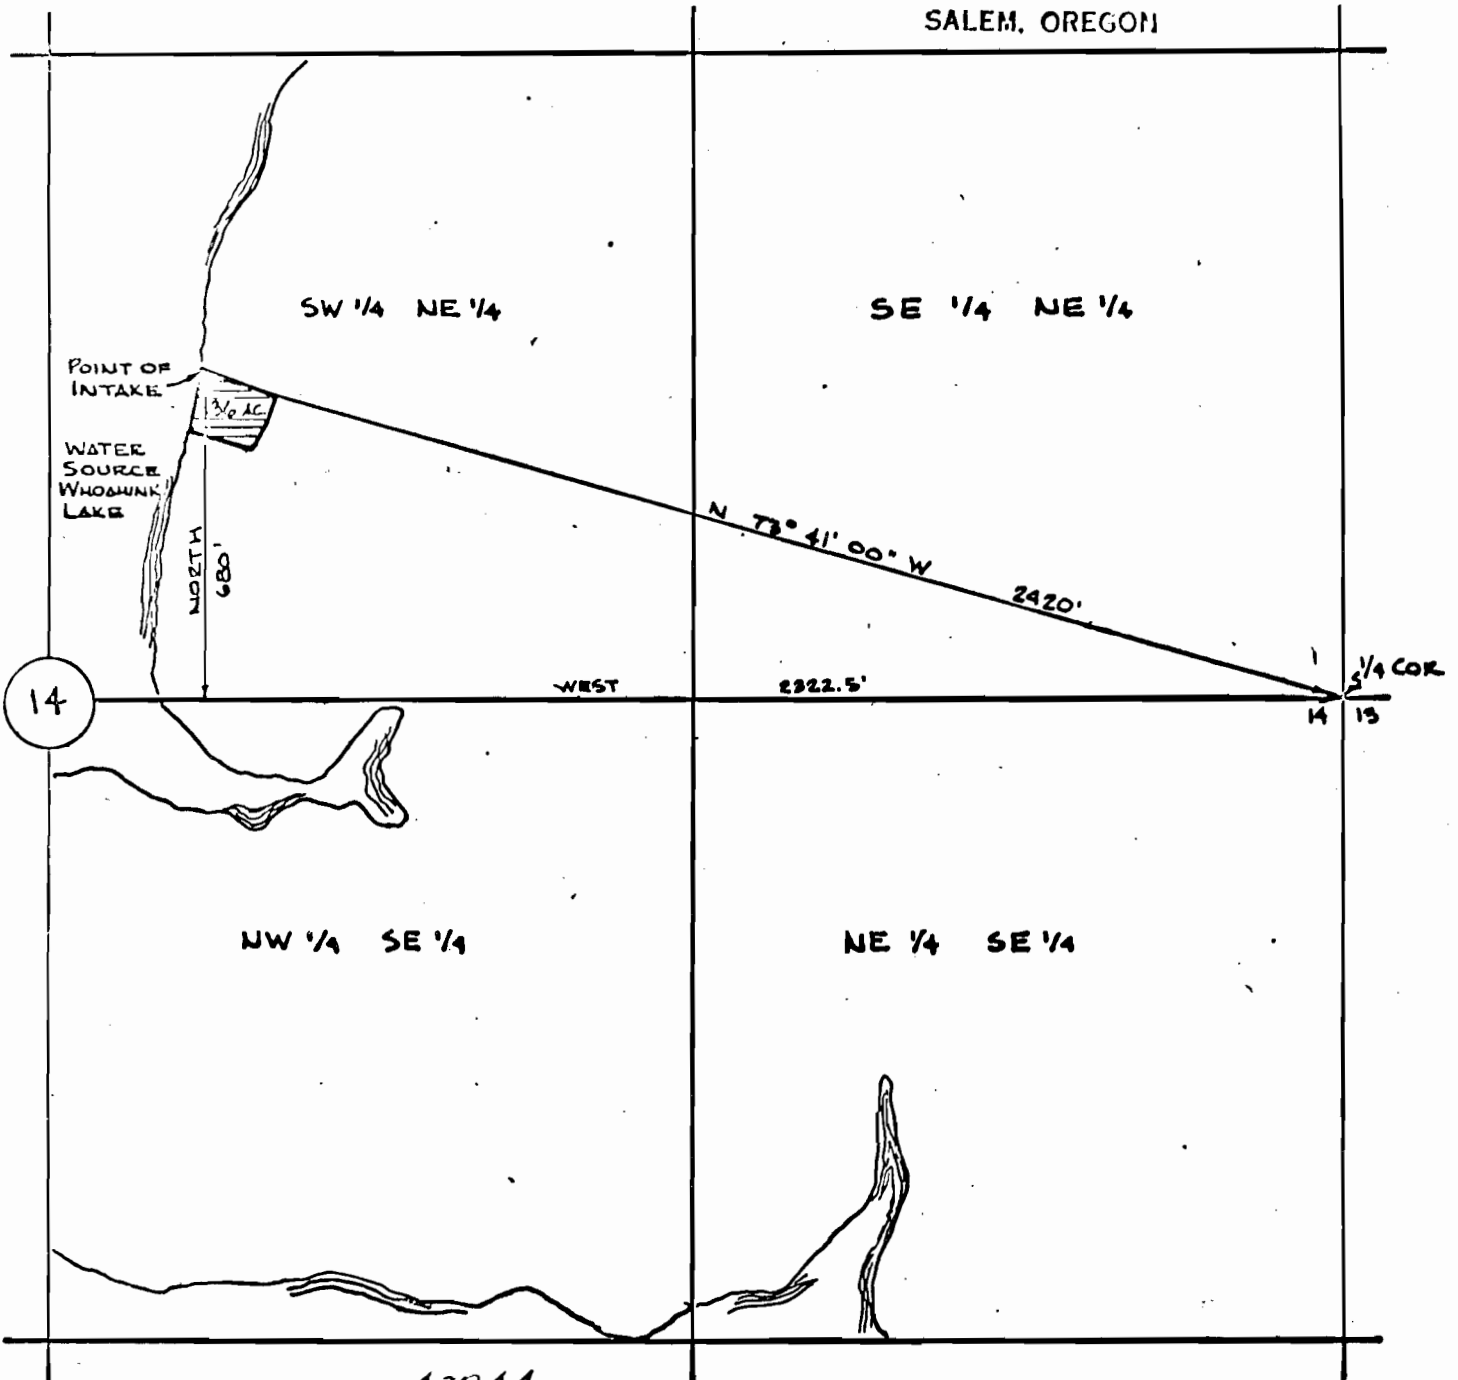

49844

37305

WATER RIGHTS MAP
ROBERT & MARIAN MCGUIRE

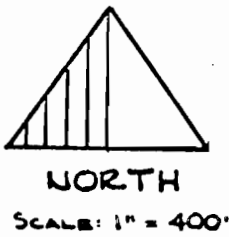

EAST 1/2, SEC 14, T 19 S, R 12 W, WM
LANE COUNTY, OREGON

PLANTS & BRITTON, Inc.
51 CENTENNIAL LOOP
EUGENE, OREGON 97401
503/688-9211