


25279
28687
44977
T3468
49711
T3468

T.39S. R. 20E.W.M.

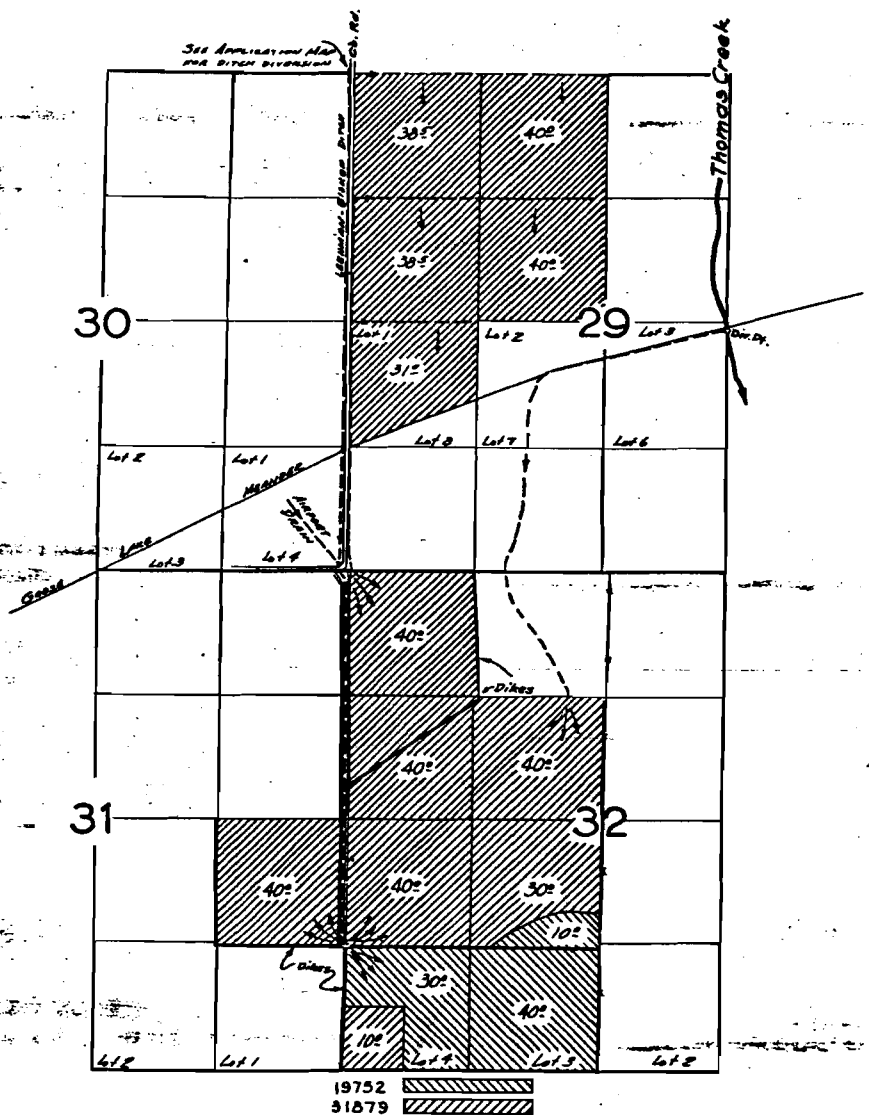

FINAL PROOF SURVEY

UNDER
19752 15338
Application No. 31679 Permit No. 25279
IN NAME OF

Surveyed May 12 1959, by R. Jackson