


T.I.S., R.I.W., W.M.

YAQUINA BAY

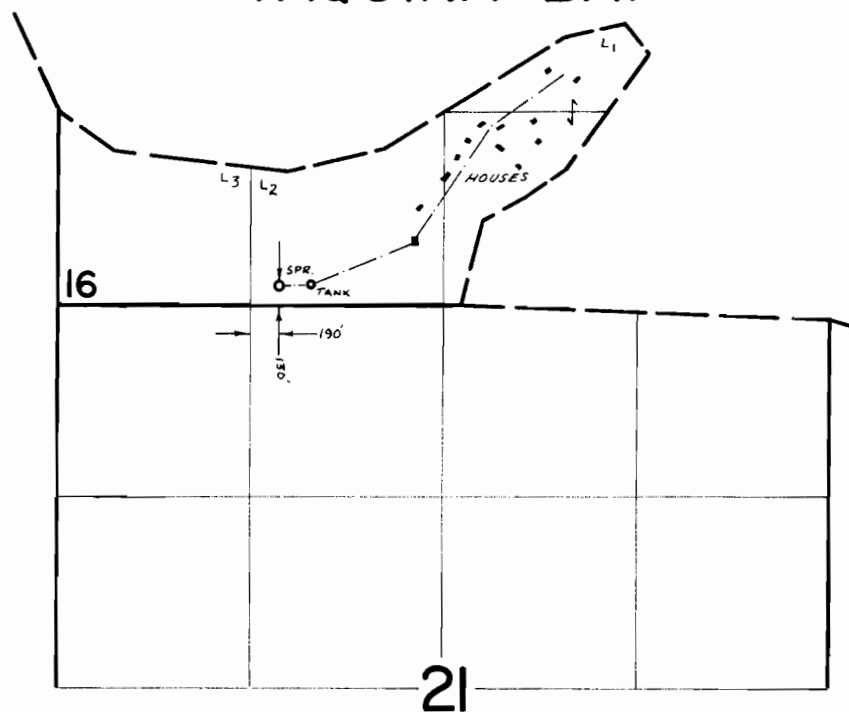

FINAL PROOF SURVEY
UNDER

Application No. 41880 Permit No. 31334
IN NAME OF

IVAN H. LEEK

Surveyed June 2 1975, by D. Norby