


T.6S.,R.10W.,W.M.

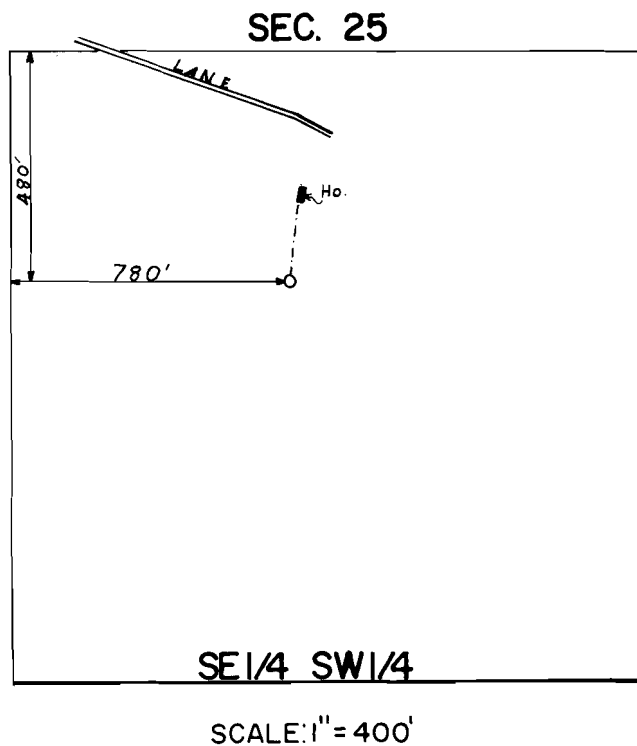

FINAL PROOF SURVEY
UNDER

Application No. 48209 Permit No. 36340
IN NAME OF

Donald Lee & Barbara Anna Davis

Surveyed JUNE 29 1976, by C.R. KING