T. 31S., R. 41 & 42 E., W.M.

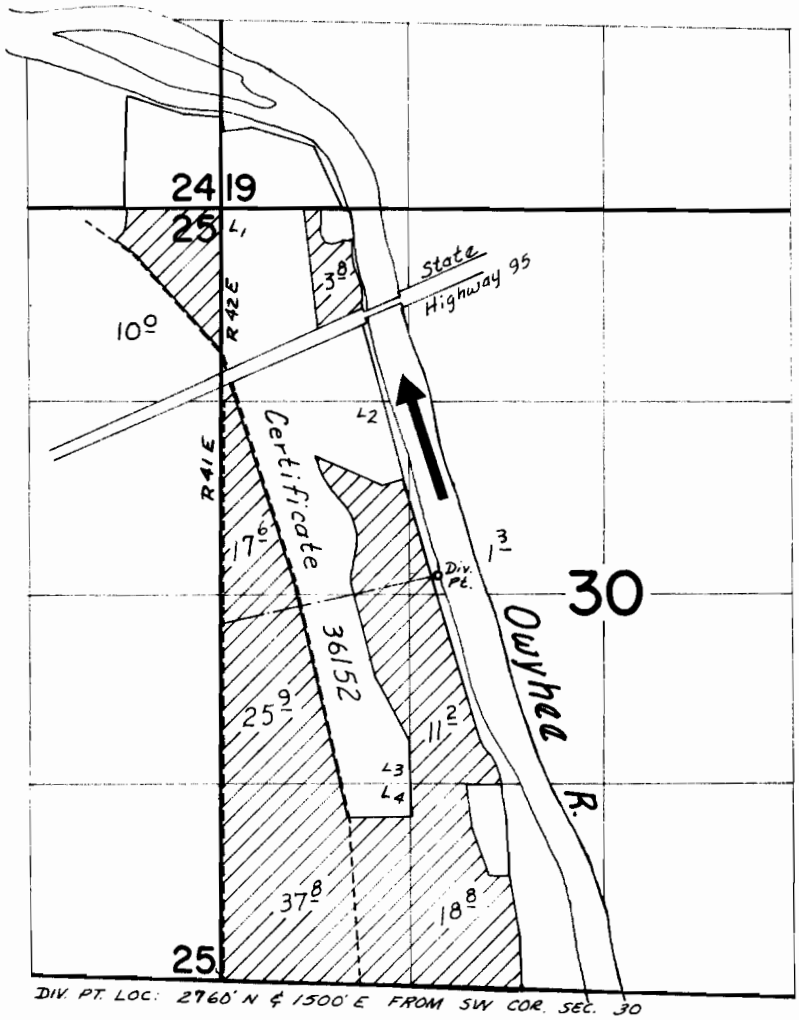

FINAL PROOF SURVEY
UNDER

Application No. 43343 Permit No. 36110
IN NAME OF

RALPH EASON

Surveyed July 14 1975, by D. Norby

BBC-7KK-100