


T.9S., R.1W., W.M.

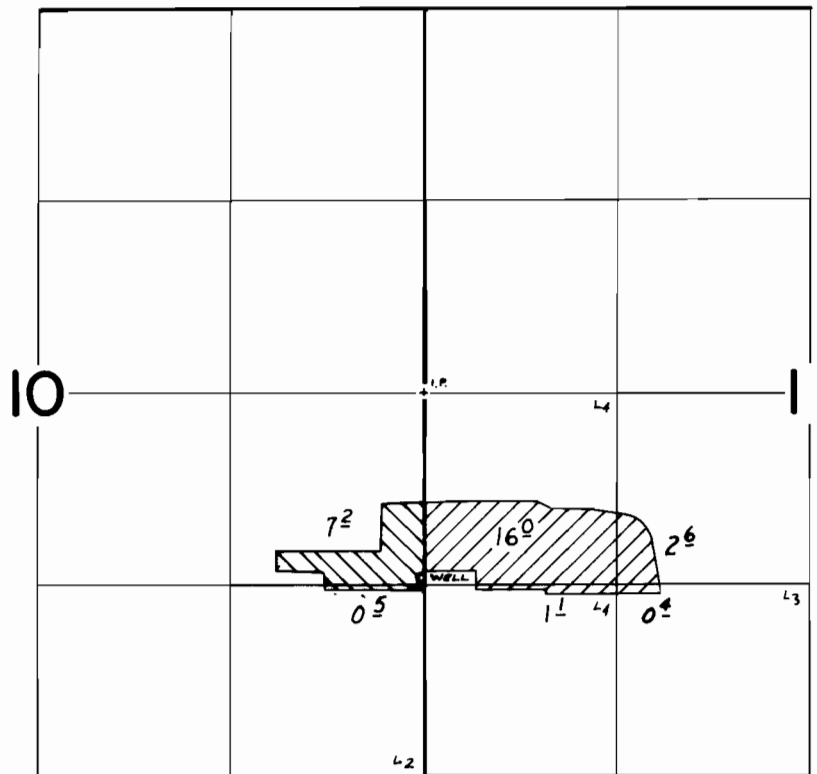

WELL LOC: 127° 3' S & 10' W FROM E 1/4 SEC. 10



FINAL PROOF SURVEY UNDER

Application No. G-5493 Permit No. G-4988
IN NAME OF

CHRIS E. NEITLING

Surveyed May 28 1975, by D. Norby