


T.4S. R.1W. W.M.

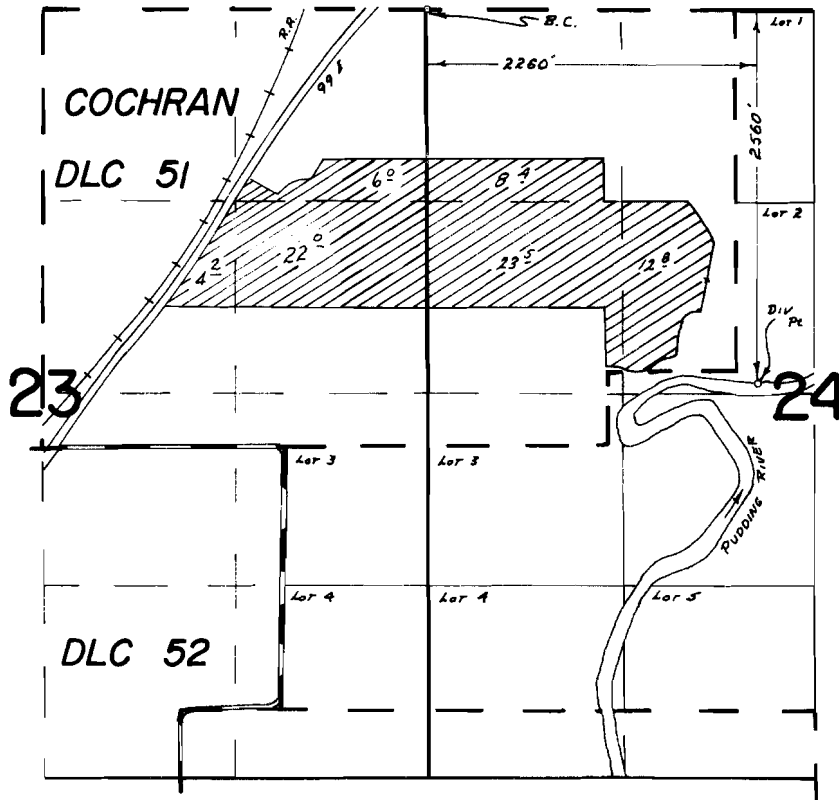

FINAL PROOF SURVEY UNDER

Application No. 45176 Permit No. 33751
IN NAME OF

EDWARD E. & M. VEVA BRADTL

Surveyed June 4 1973, by R. G. MUCKEN
July 31 75 D. NORBY