


# T.8S., R.2W., W.M.

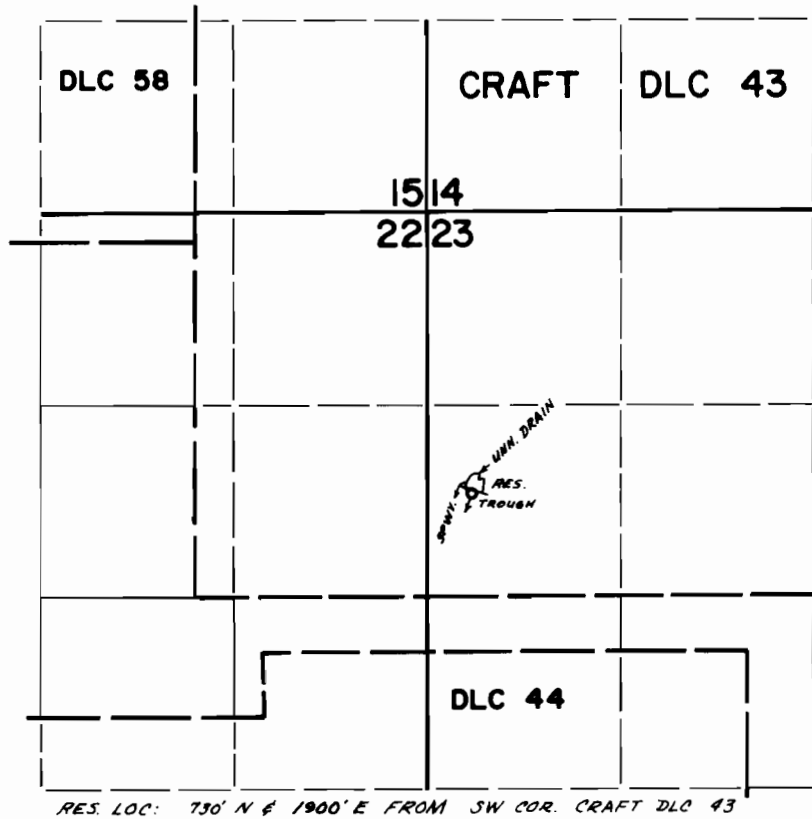

## FINAL PROOF SURVEY UNDER

Application No. R-47970 47971 Permit No. R-5824 35983  
IN NAME OF

CLYDE L. THOMMEN

Surveyed Mar. 25 1975, by D. Norby