


T.8S., R.2W., W.M.

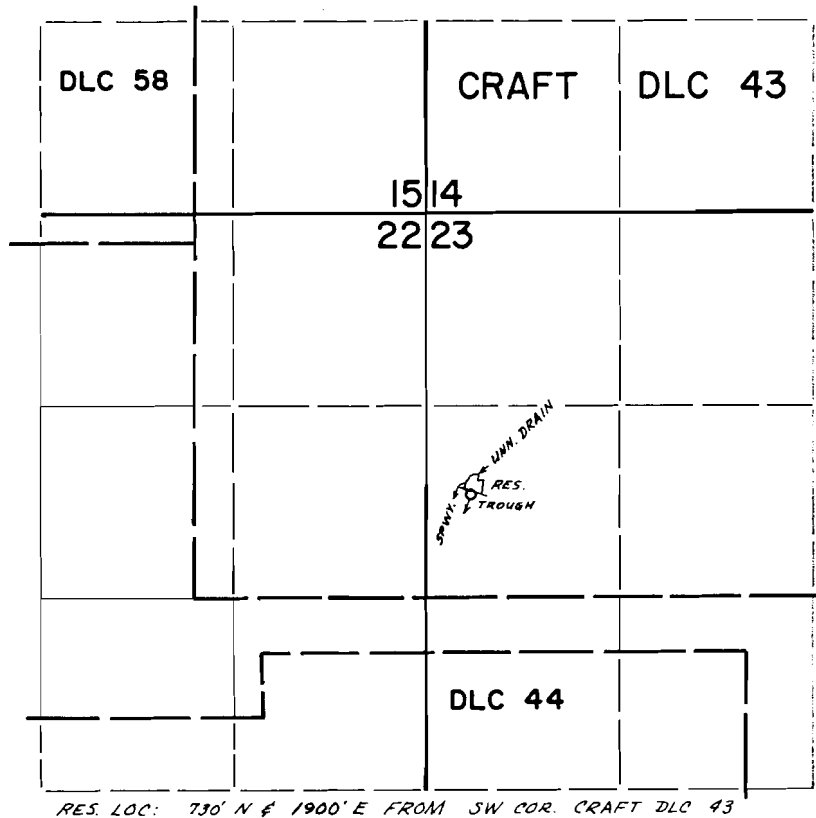

FINAL PROOF SURVEY UNDER

R-47970 R-5824
Application No. 47971 Permit No. 35983
IN NAME OF

CLYDE L. THOMMEN

Surveyed Mar. 25, 1975, by D. Norby