


T. 5S. R. 1W. W.M.

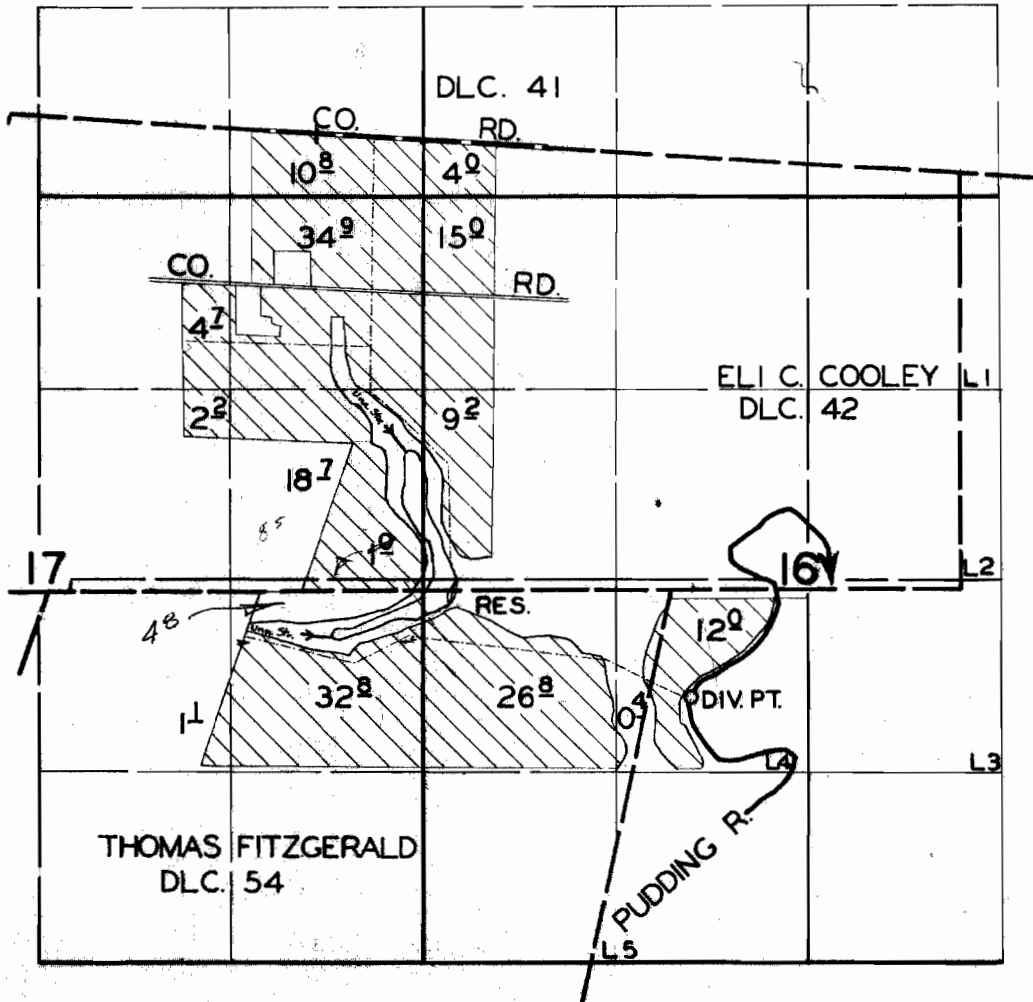

**FINAL PROOF SURVEY**

UNDER

R-23868

R-1009

Application No. 23869 Permit No. 19180...

IN NAME OF

**JOSEPH SERRES**

Surveyed 1 MAR. 1956, by R.D. BEST