


T. 1 S. R. 4 E. W. M.

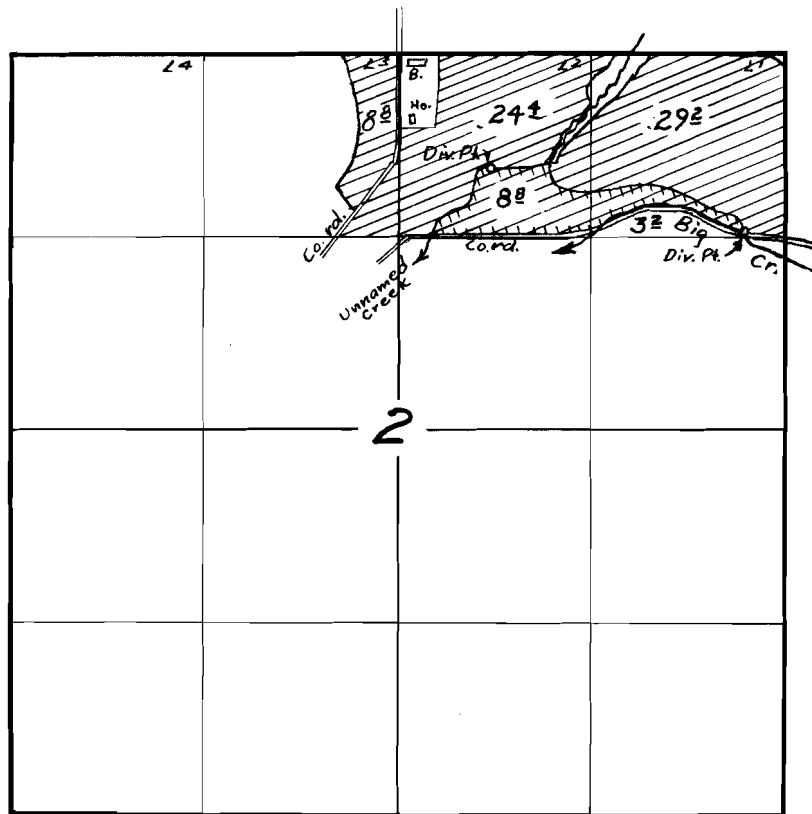

FINAL PROOF SURVEY
UNDER

Application No. 20368 Permit No. 15917....
IN NAME OF

Frank A. Windust & Arthur J. Blanc

Surveyed 31 July 1956, by m. B. B.....