


# T.7S. R.4W. W.M.

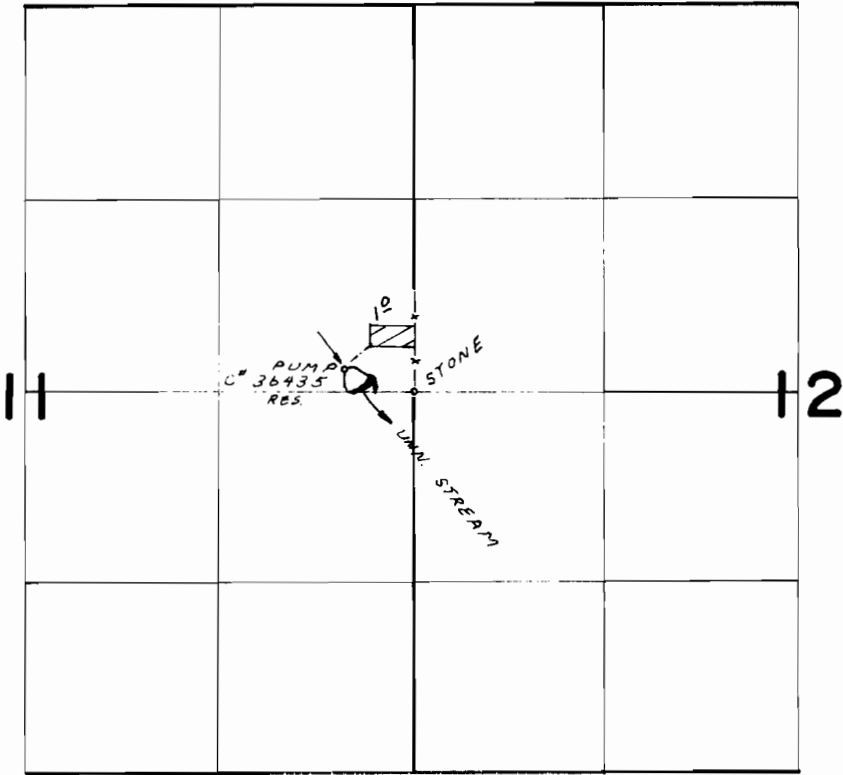

DAM LOC. 40' N. & 400' W FROM E  $\frac{1}{4}$  COR. SEC. 11

FINAL PROOF SURVEY

46535

34767

RICHARD C. SYNOWSKI

OCT. 17 1975 by L.H. NUNN