


T. 3 S. R. 39 E. W.M.

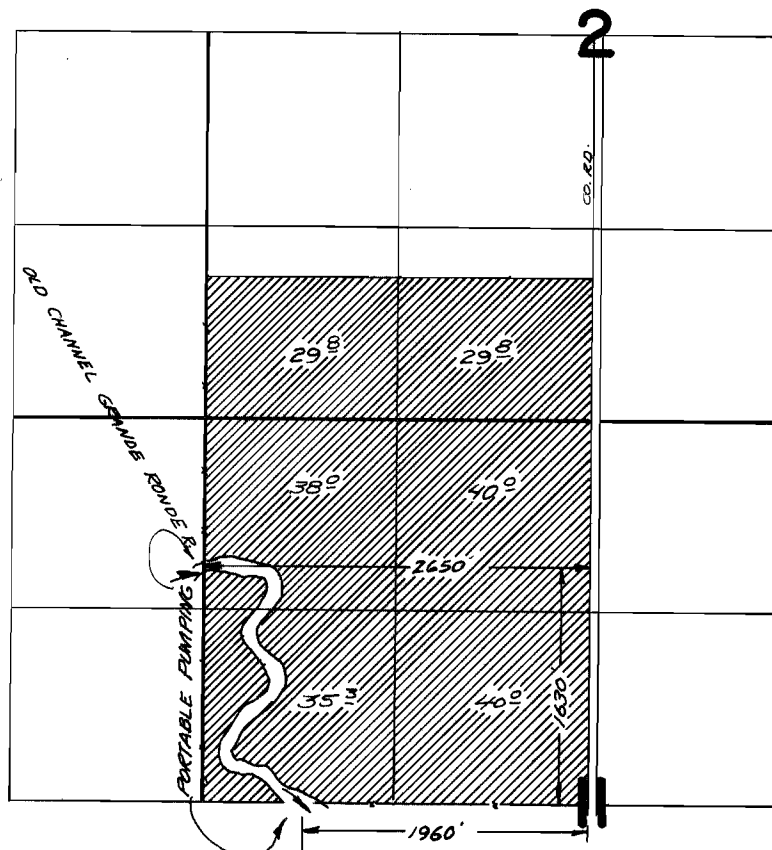

THE DIVERSION POINT ON THE NEW CHANNEL OF THE GRANDE RONDE RIVER IS LOCATED ON THE SOUTH BANK OF THE CHANNEL 60 FEET WEST OF PEACH LAKE. BEING FURTHER DESCRIBED AS 560 FEET N & 60 FEET W FROM THE CENTER OF SECTION 32. BEING WITHIN THE SEC NW 1/4 OF SECTION 32 T.2S. R.39E. W.M.

FINAL PROOF SURVEY
UNDER

Application No. 37813 Permit No. 28359
IN NAME OF

EVERETT L. HAMANN

Surveyed Aug 28 1968, by V. Garner