


T.2S. R.44E. W.M.

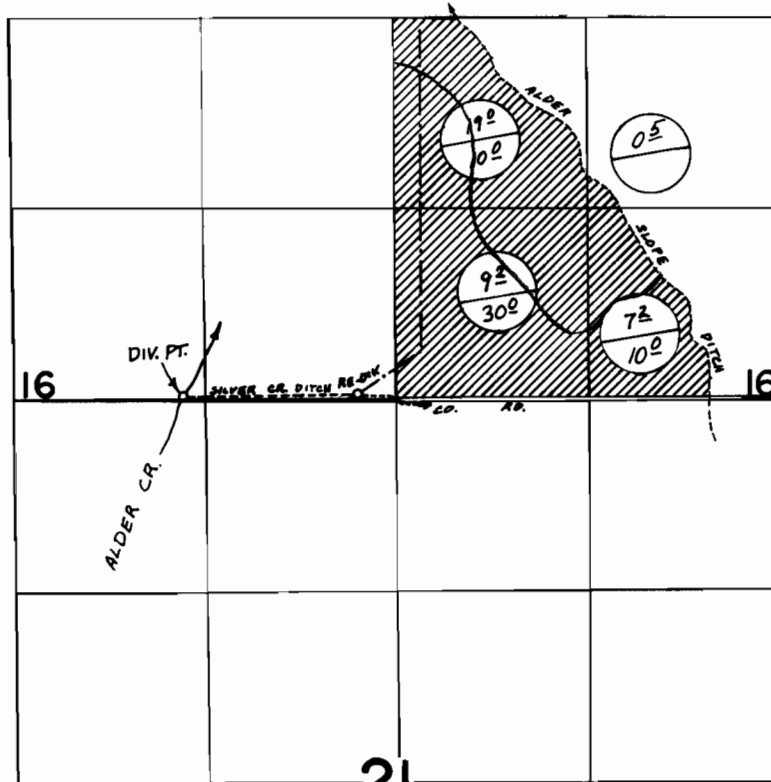

DIV. PT. LOC.: 10' N. & 1460' W. FROM N 1/4 COR. SEC 21



FINAL PROOF SURVEY UNDER

Application No. 41694 Permit No. 31405
IN NAME OF

WAYNE & MELICE A. COOK

Surveyed NOV. 1 1975, by L. H. NUNN