


T. 1 N. R. 42 E. W. M.

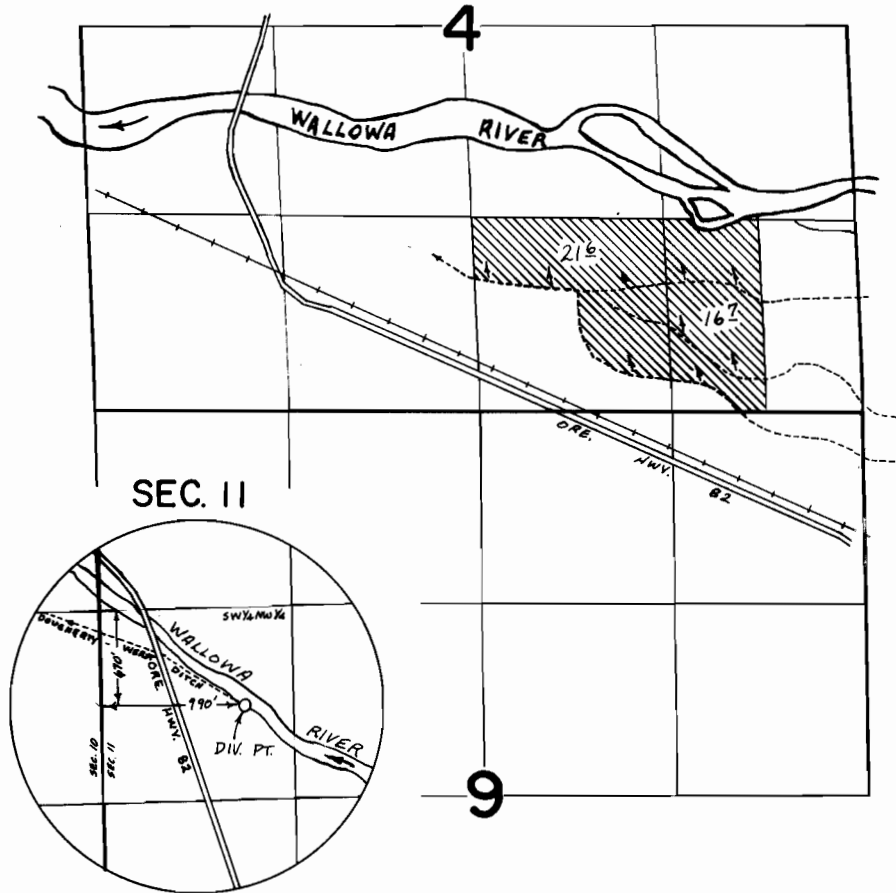

FINAL PROOF SURVEY
UNDER

Application No. 44607 Permit No. 33383
IN NAME OF

NORMAN WERST

Surveyed NOV. 1 1975 by L. H. NUNN