


T.3S. R.45E. W.M.

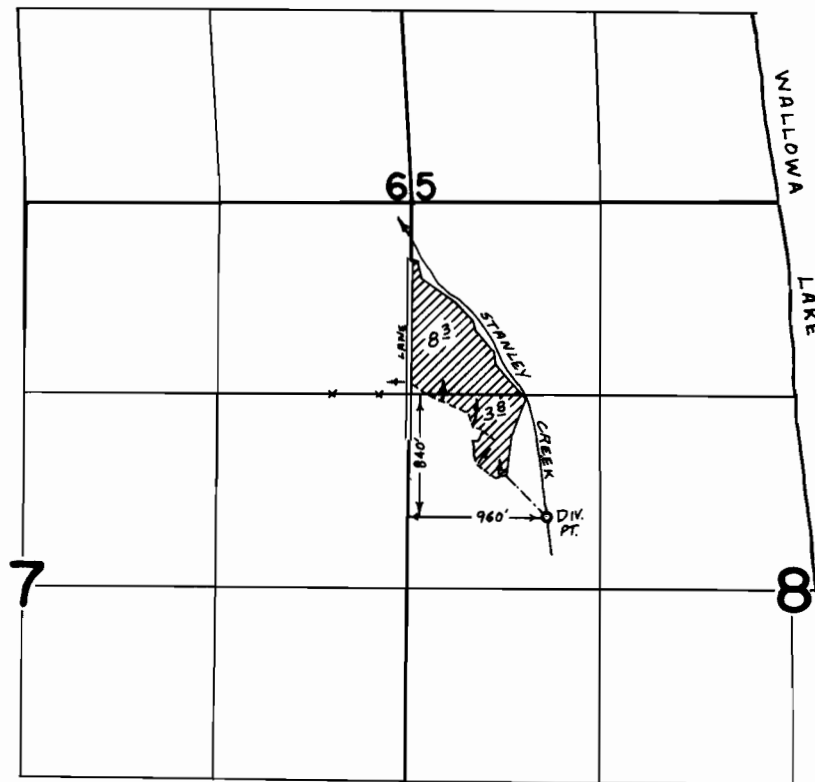

FINAL PROOF SURVEY
UNDER

Application No. 47489 Permit No. 35260
IN NAME OF

J. T. BRYANT

Surveyed NOV. 5 1975, by L. H. NUNN