


T. 1N. R. 42E. W.M.

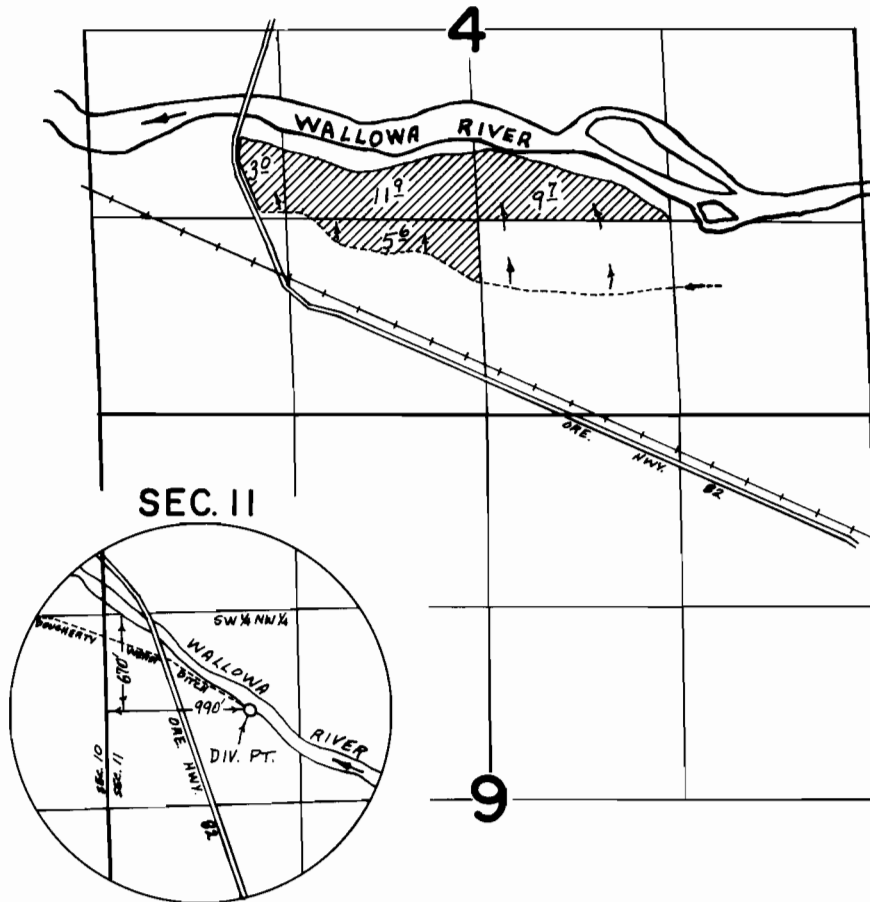

FINAL PROOF SURVEY UNDER

Application No. 48975 Permit No. 36660
IN NAME OF

THOMAS G. SCOTT

Surveyed NOV. 1 1975, by L. H. NUNN