


T.2S.R.1W.W.M.

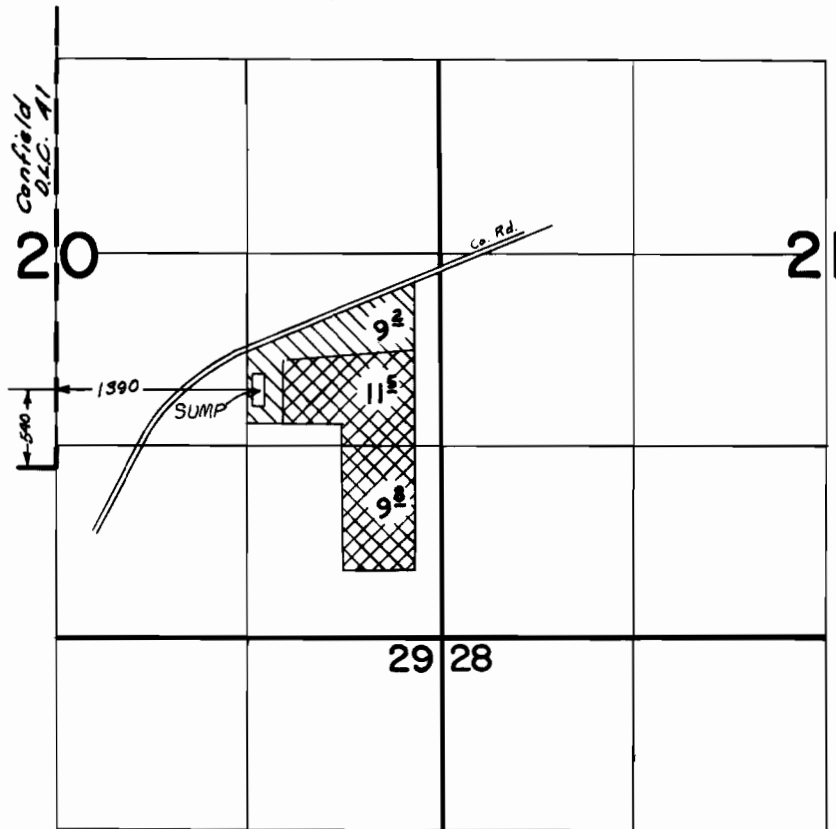

-  PRIMARY
-  SUPPLEMENTAL

FINAL PROOF SURVEY UNDER

Application No. G-4614 Permit No. G-4258
IN NAME OF

..... DONALD E. BISCHOF

Surveyed OCT 5 1972, by L. GOULD