


T.1S., R.3W., W.M.

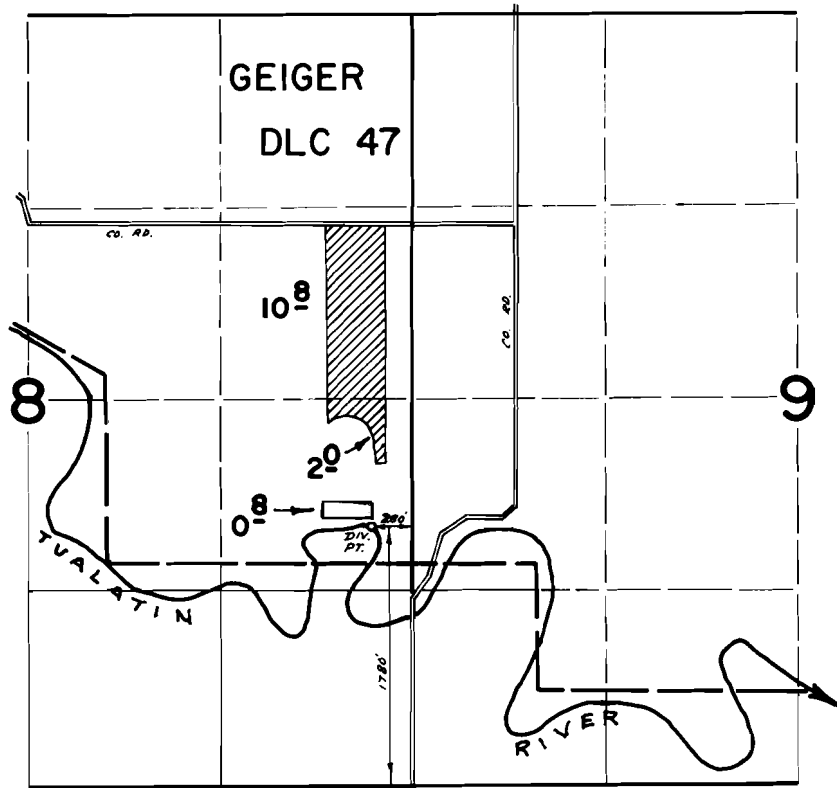

**FINAL PROOF SURVEY**  
UNDER

Application No. 45650 Permit No. 34043  
IN NAME OF

LOYAL AND COLETA LEFORE

Surveyed Aug. 6 1975, by R.G. Mucken