

2

1

11

12

14

13

21

22

*NOTE: Streams sketched in approximate location except in the vicinity of irrigated land.*

28

27

33

34

*Surveyed Nov. 14 to 18, 1925.*

16

21

17

20

CREEK

FORK

WEST

18

19

x

28

33


29

32

30

31

TOWNSHIP 6 S., RANGE 20 E.

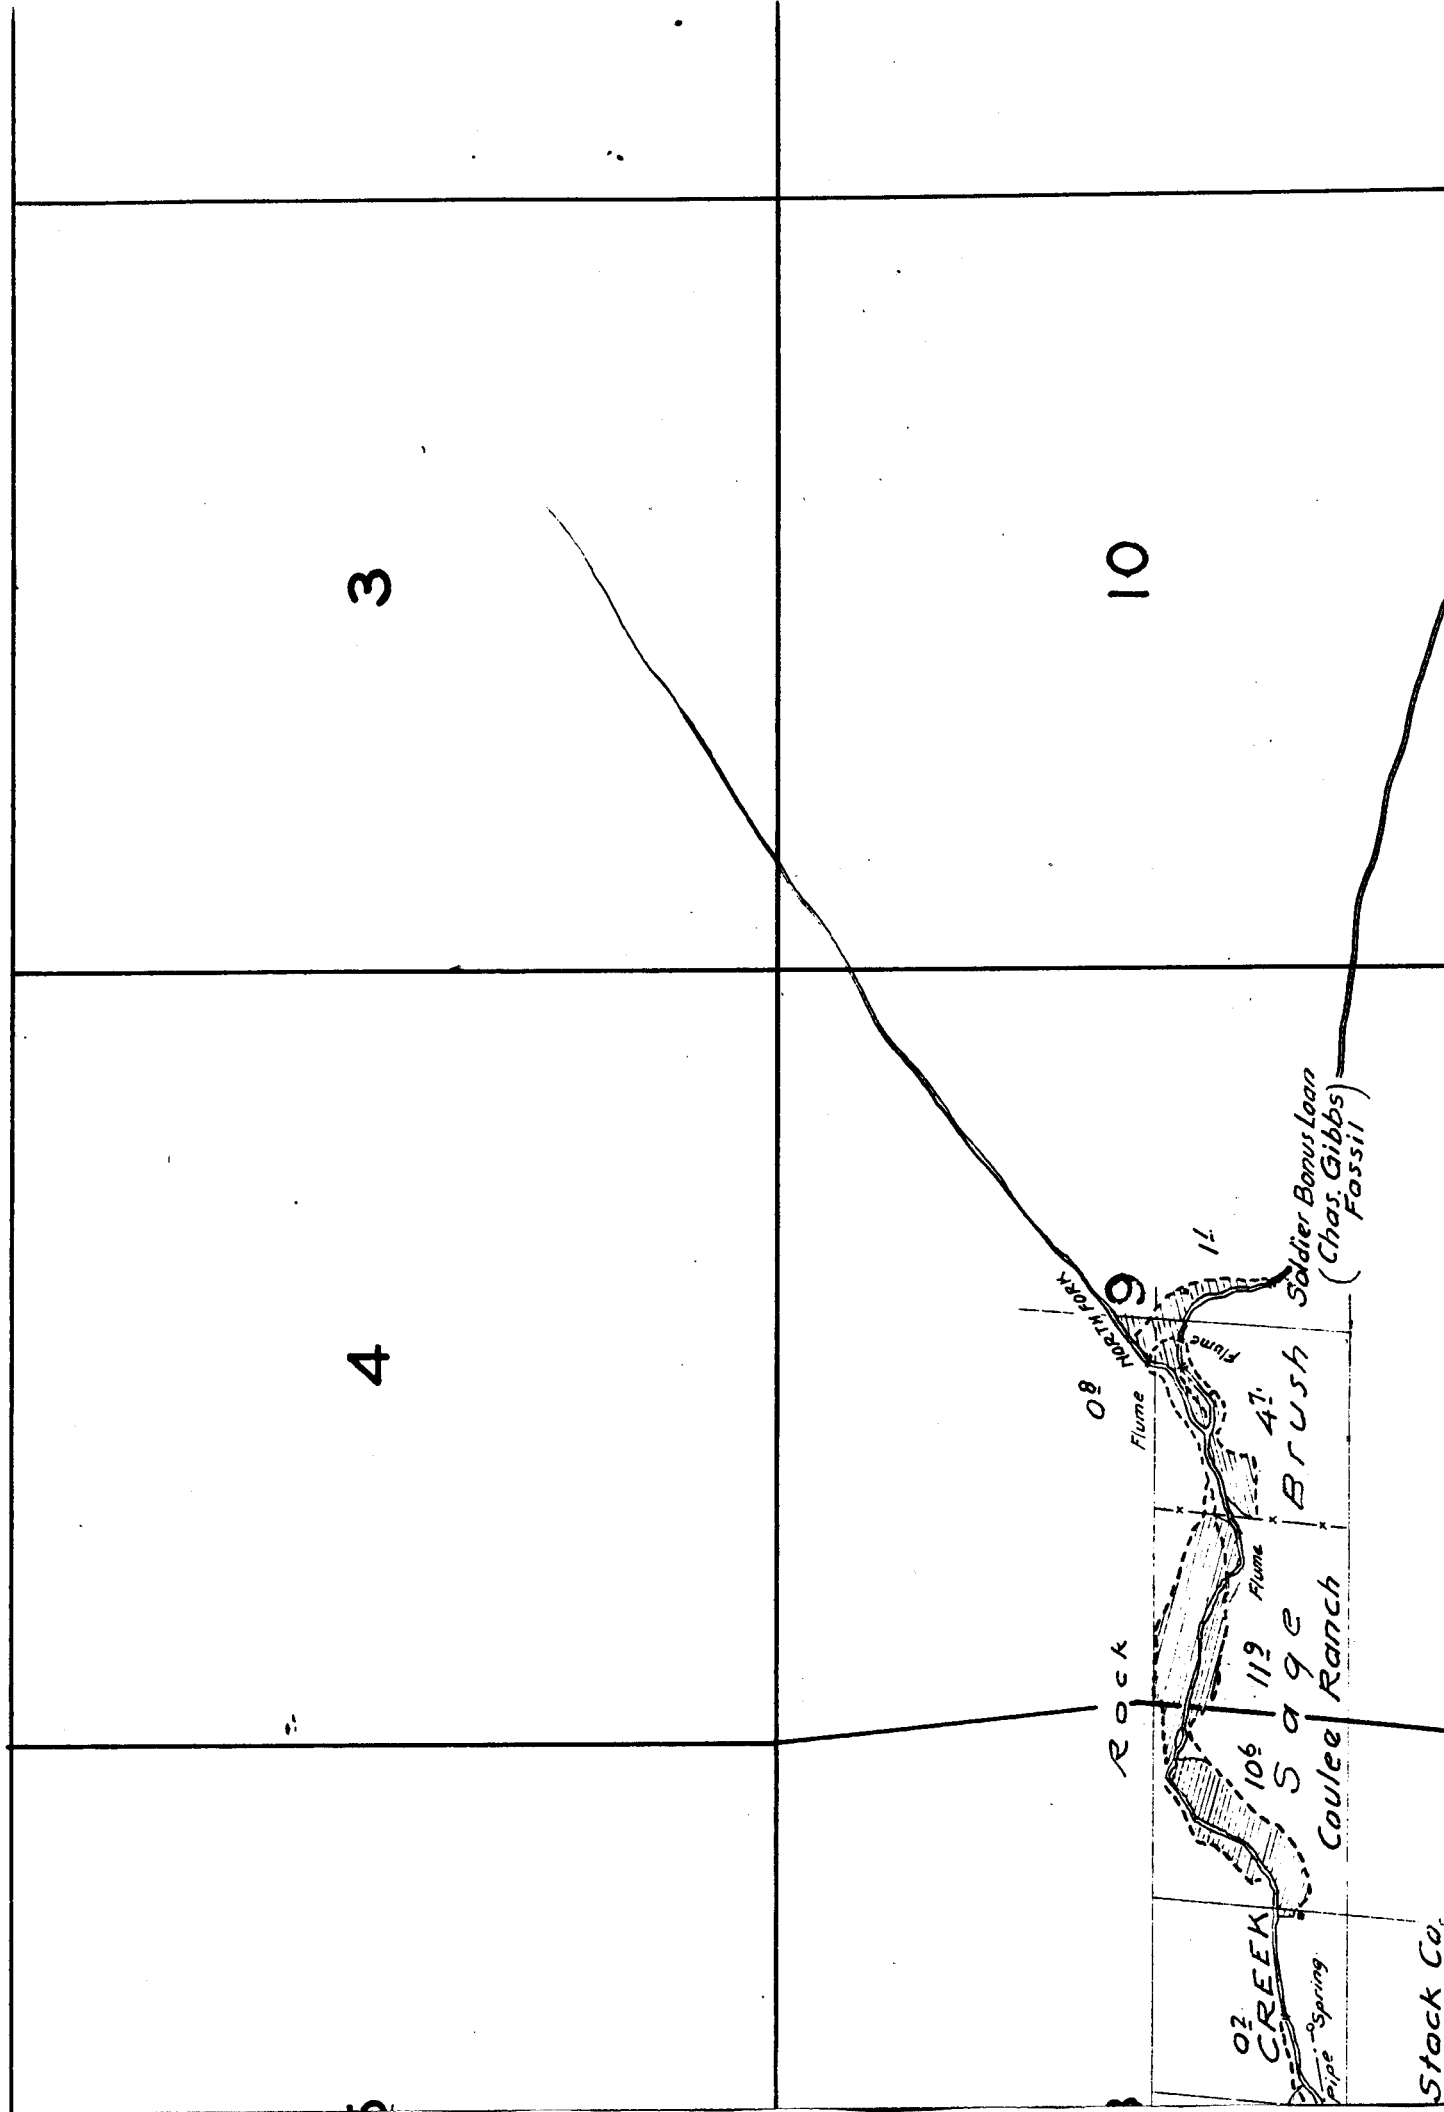

Stock Co.

x

Surveyed Nov. 14 to 18, 1925.

16

21

12

Wm. H. Higglis  
(Ad. Cornett)

15

41

Arthur Penrecoast

Rock

05

Flume 1

50

Schec

21

22


NOTE: Streams sketched in approximate location, except in the vicinity of irrigated land.


6

5

7

8

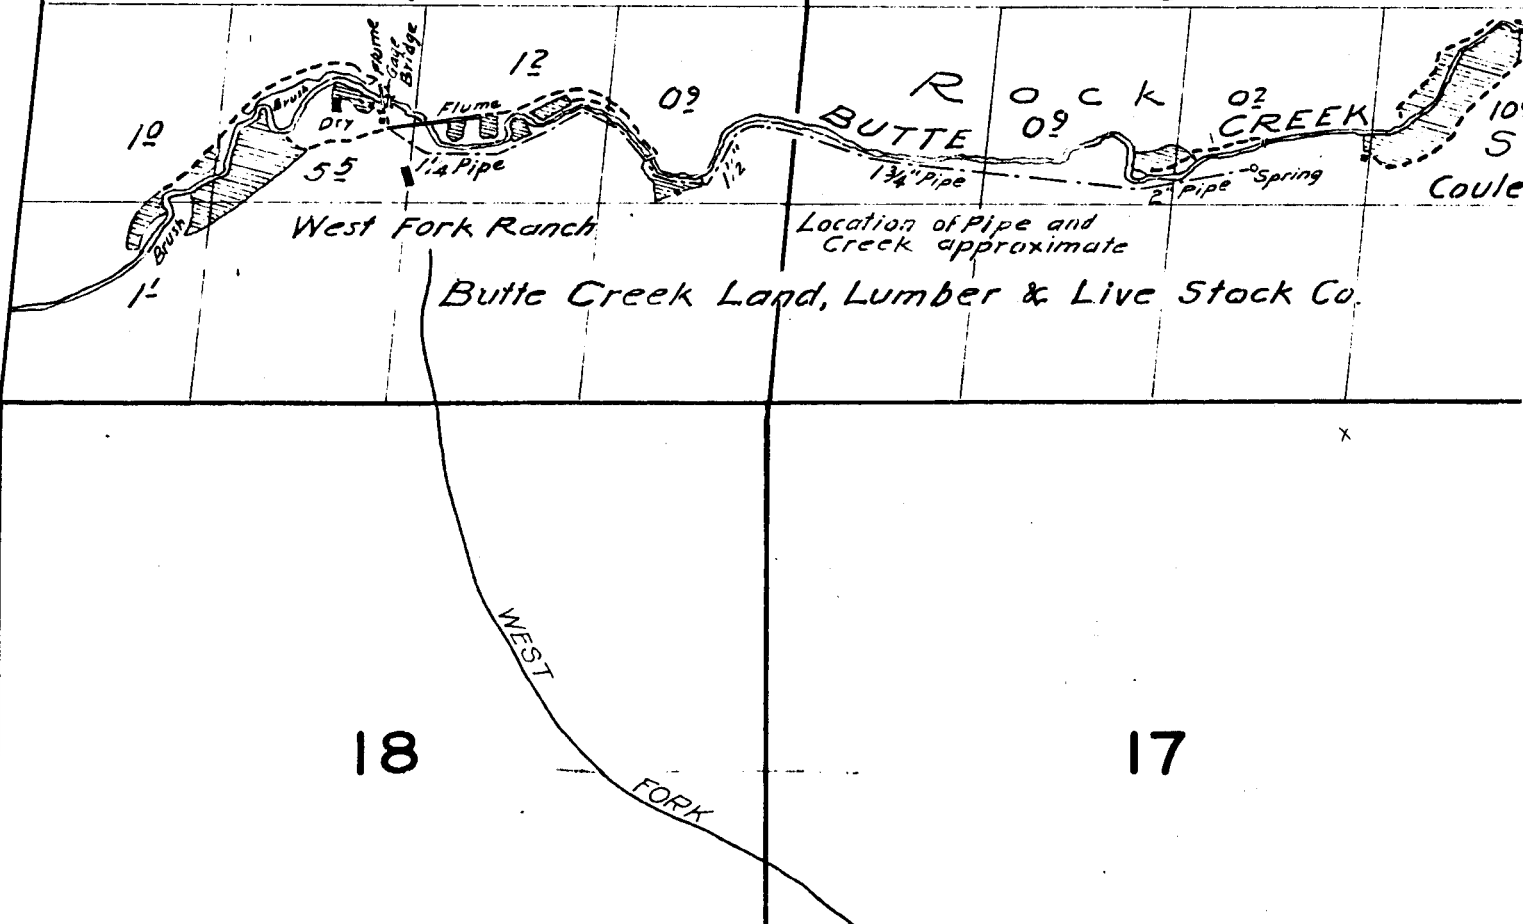

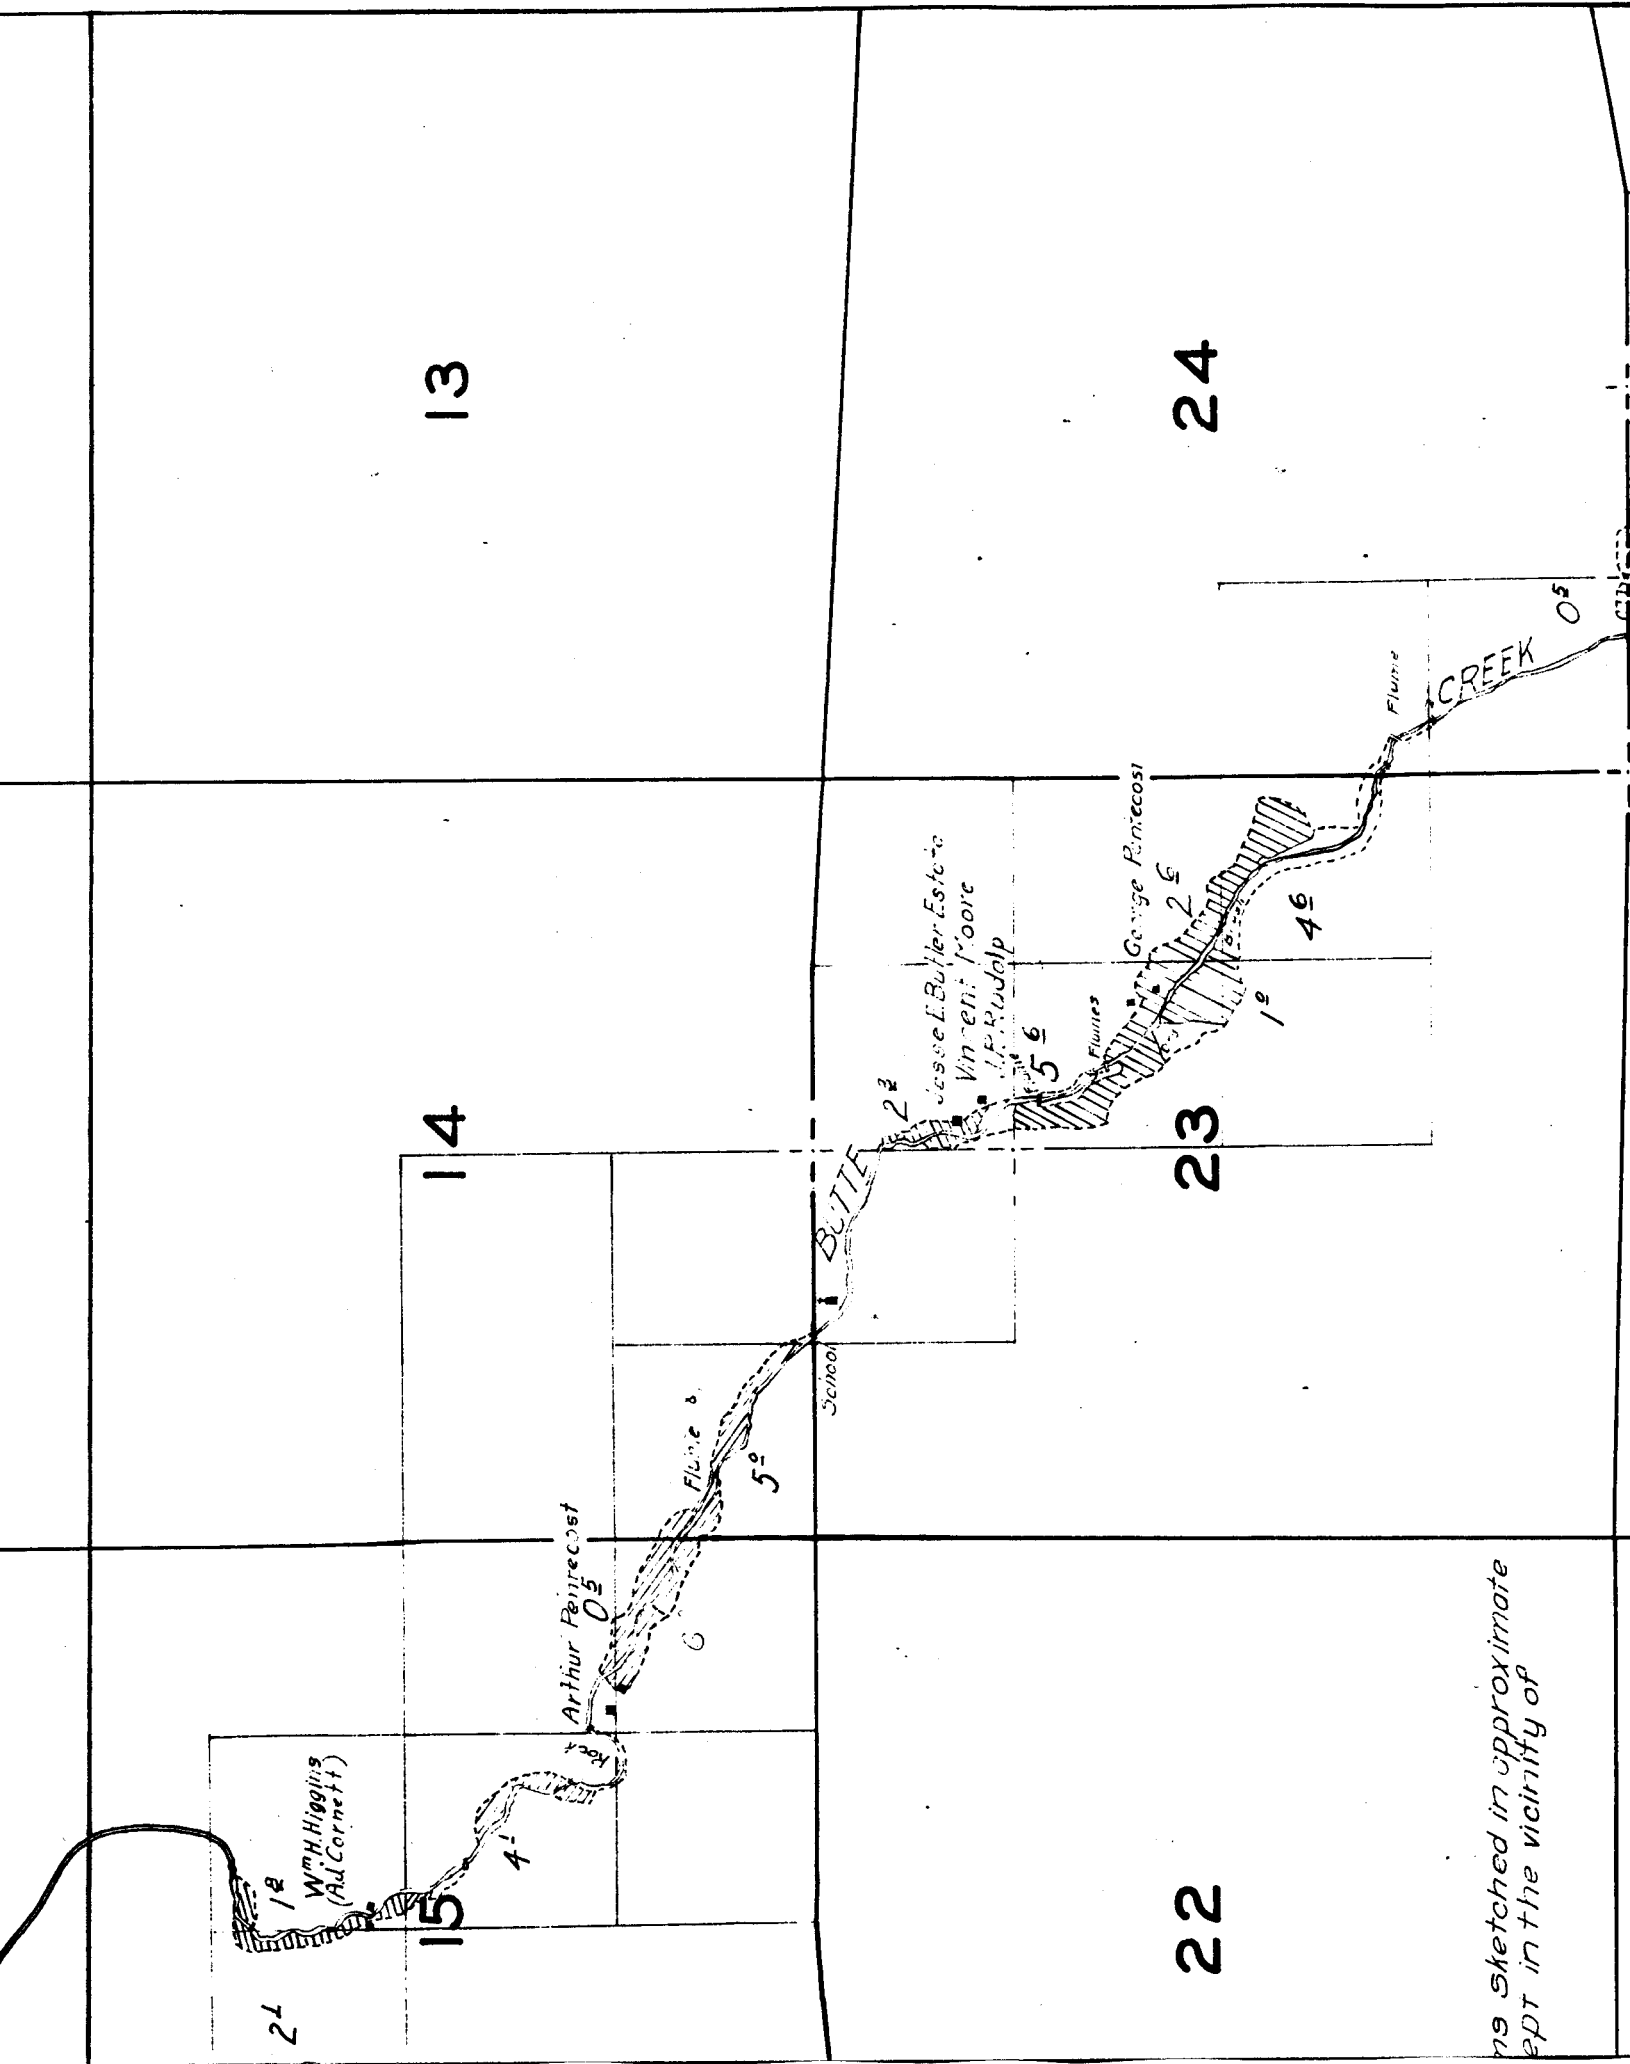

27

26

34

35

36

Stewer & Carpenter Bank

12

50 ft  
Pipe  
Spring

Black Stamp Creek

Mrs. Margaret E. Burner  
Cit Brown

32

102

23

25

35