


T.5S.R.7 W.W.M.

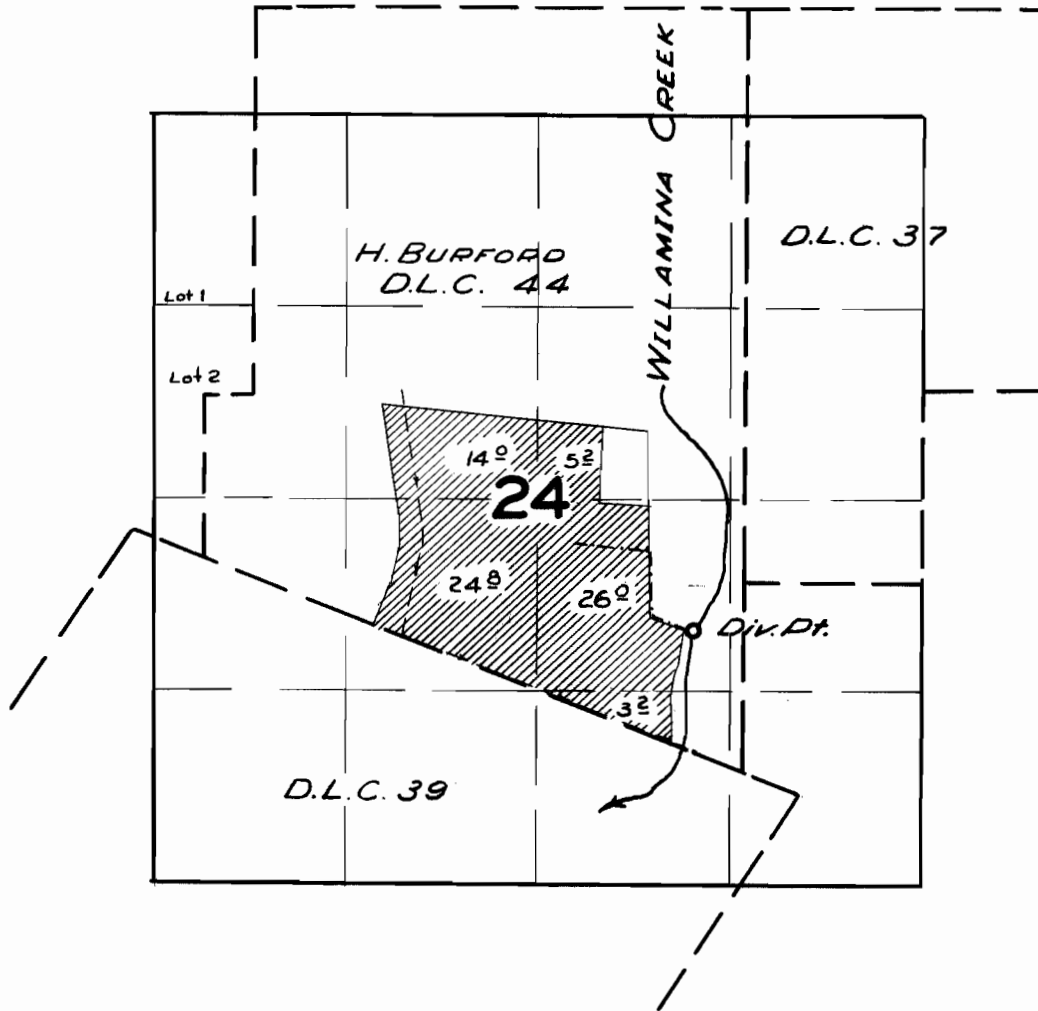

**FINAL PROOF SURVEY**  
UNDER

Transfer No. F-41  
Application No. 32935 Permit No. 26028  
IN NAME OF

ELDON FENDALL

Surveyed 19 MAY 1960 by M. Bish