


# T.3S.R.1E.W.M.

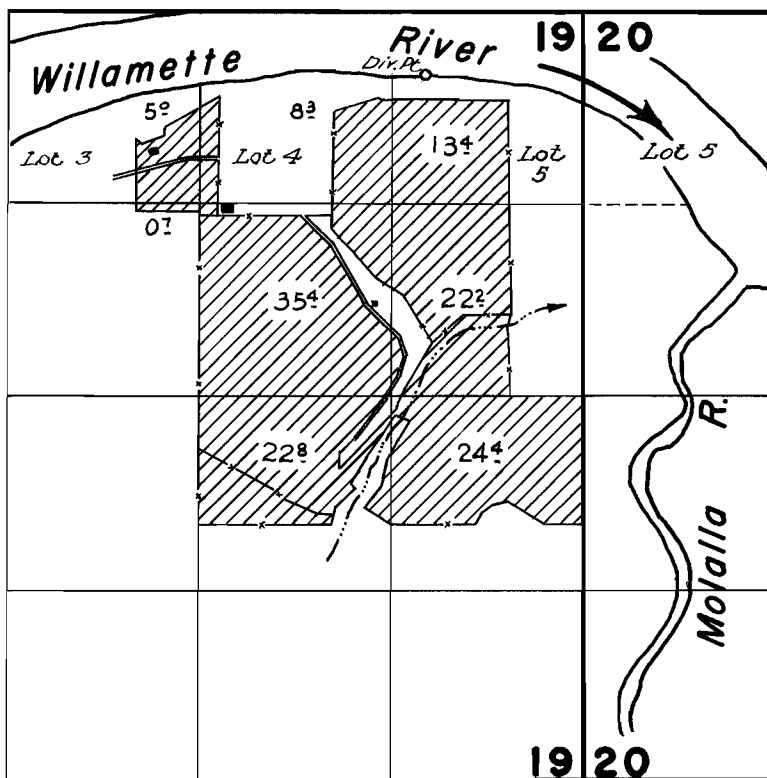

## FINAL PROOF SURVEY UNDER

Application No. **31512** Permit No. **24858**  
IN NAME OF

**GEORGE F. & LEONA IRENE WEICKER**

Surveyed Sept. 3 & 4 1959, by

*[Handwritten Signature]*