


# T.28S, R.10W, W.M.

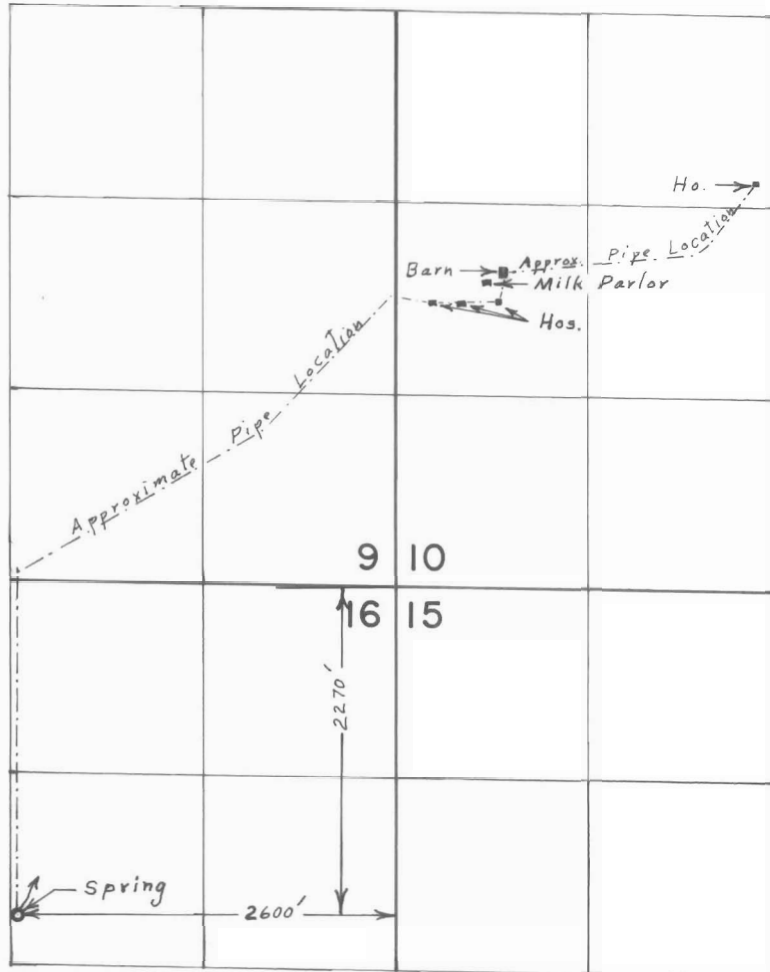

## FINAL PROOF SURVEY UNDER

Application No. 46848 Permit No. 35030  
IN NAME OF

KENNETH LAIRD

Surveyed Oct. 28, 1975, by L. E. Gould