


T.27S.R.12W.W.M.

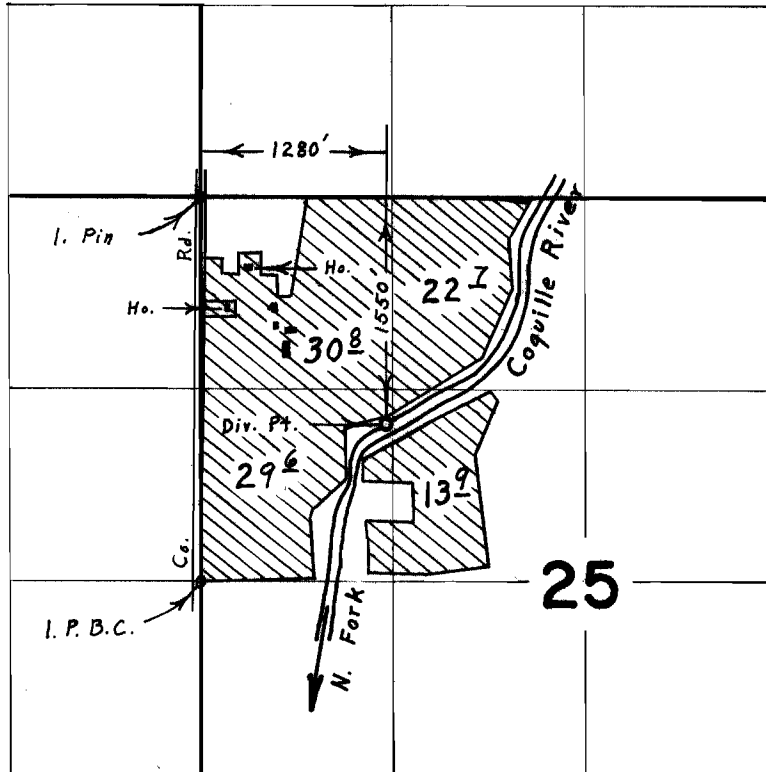

FINAL PROOF SURVEY UNDER

Application No. 39677 Permit No. 29480
IN NAME OF

LESTER W. & LOUISE GARDNER

Surveyed Oct. 8, 1966, by L. E. Gould