


T.16S.R.18E.W.M.

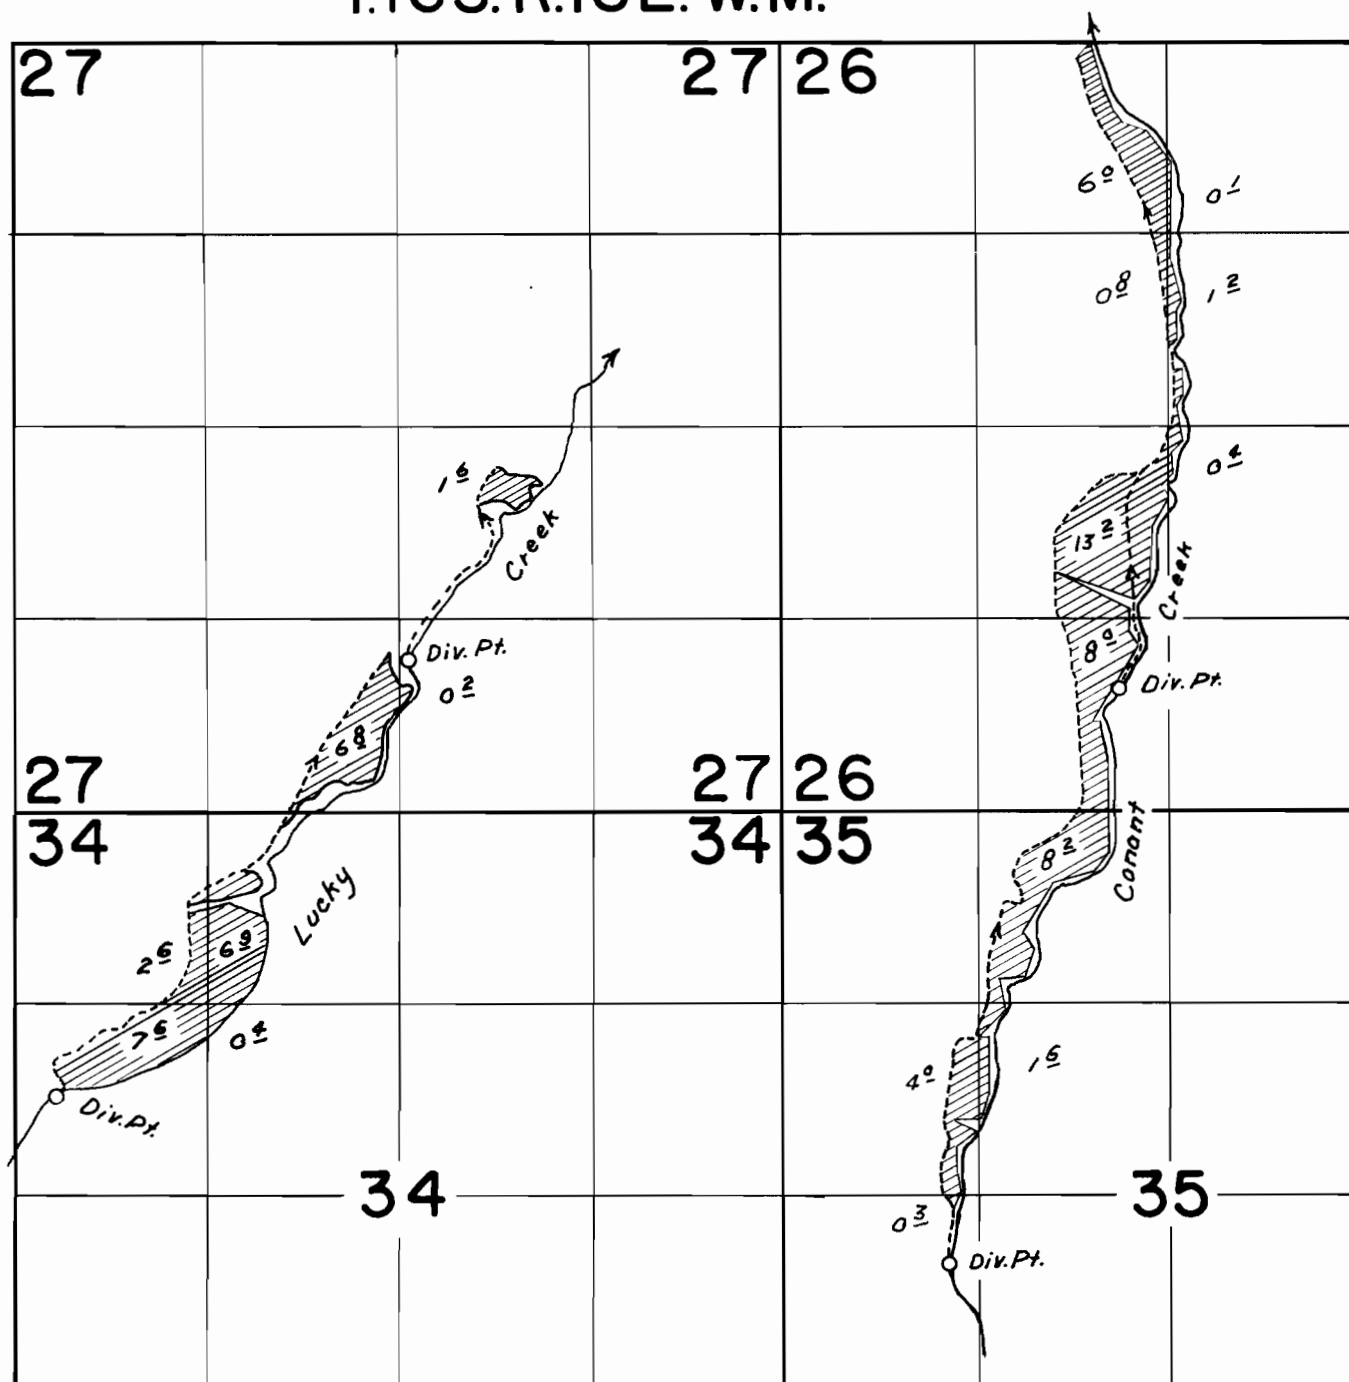


FINAL PROOF SURVEY
UNDER

Application No. 28552 Permit No. 22333
IN NAME OF

JOHN BEOLETTO

Surveyed Oct. 1, 1964, by C.J. Gardner

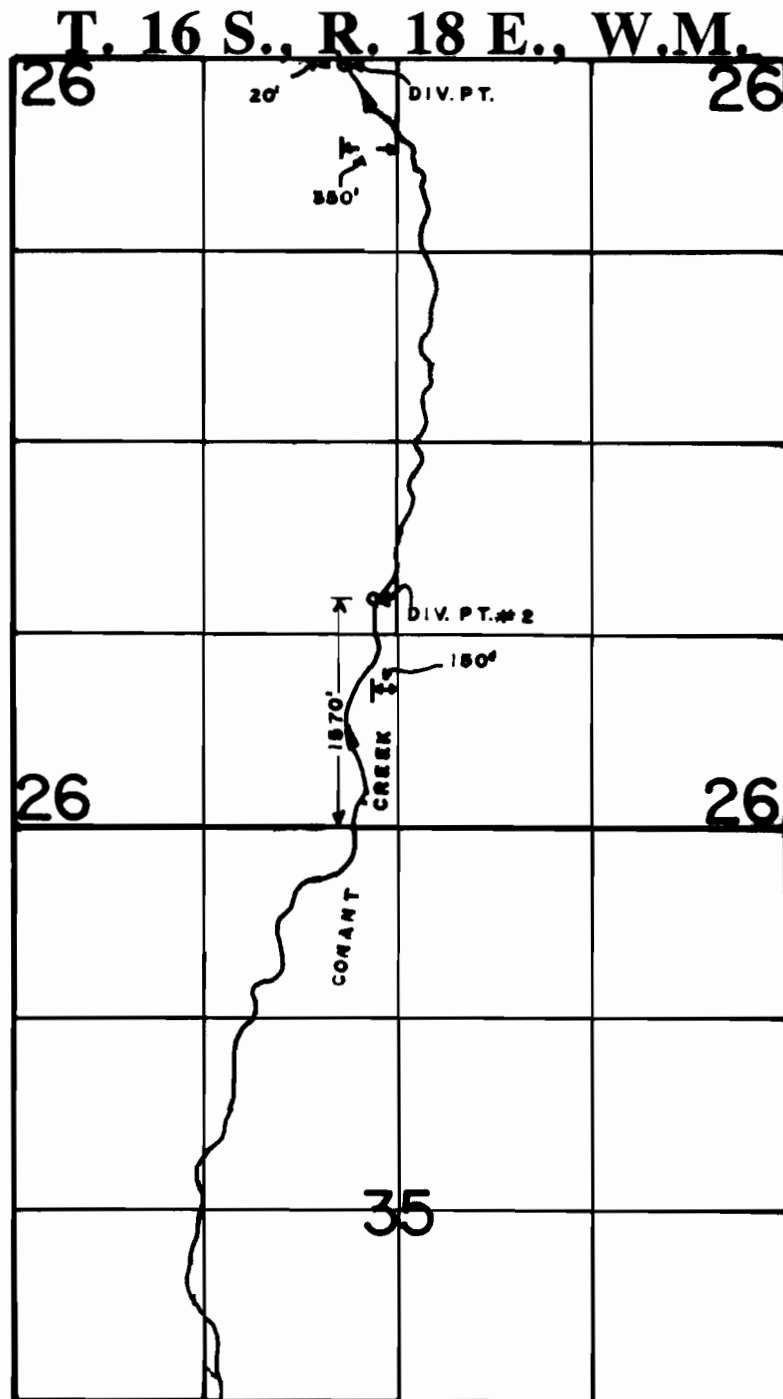

FINAL PROOF SURVEY

UNDER

TRANSFER NO. 3499

IN NAME OF

JOHN & DOLLY BEOLETTO

Surveyed NOV 3, 1992, by R.M.SUTTERFIELD

SCALE: 1"=1320'