T.30S. R.3W. W.M.

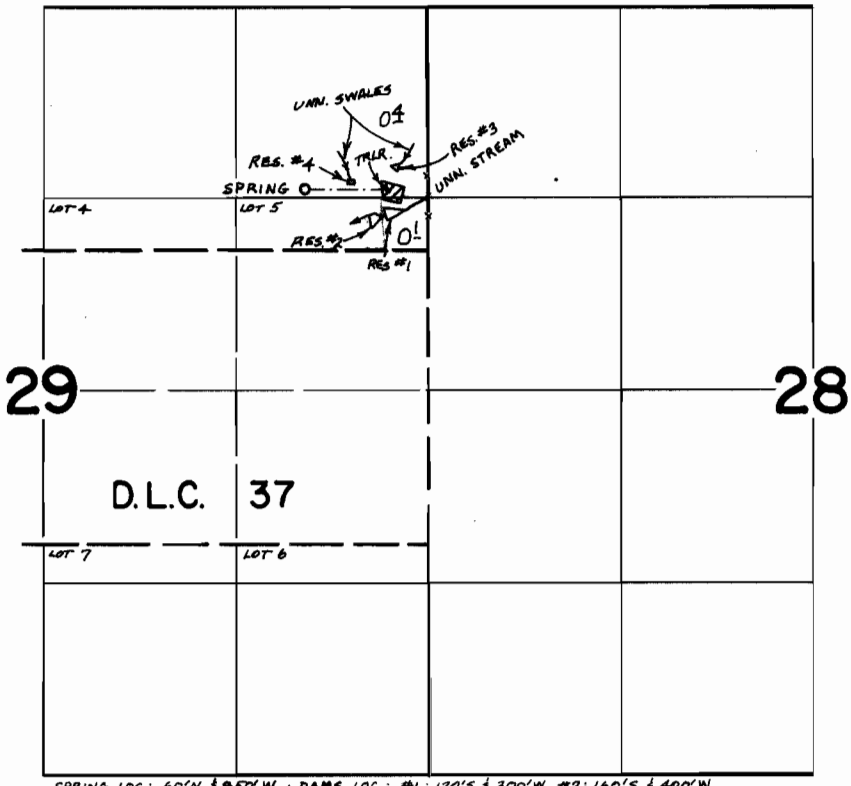

SPRING LOC.: 60'N. & 850'W.; DAMS LOC.: #1: 120'S. & 300'W, #2: 160'S. & 400'W., #3: 200'N. & 240'W., #4: 90'N. & 530'W. ALL FROM SE COR NE¼ NE¼ SEC 29.

FINAL PROOF SURVEY
UNDER

Application No. R-49857 49858 Permit No. R-6028 37129

IN NAME OF

CARL L. & WILMA FAY GILES

Surveyed MAY 20 1975, by L. TOLL

PTS-1975-V Dp