


T.15S. R.31E. W.M.

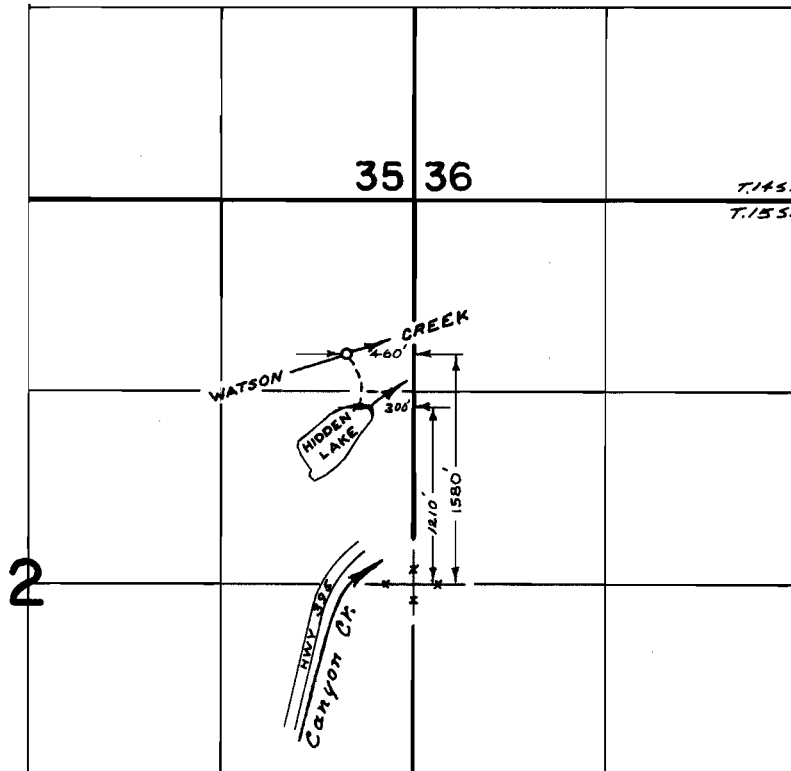

T.14S.
T.15S.

↑
Line of S. Co.

FINAL PROOF SURVEY
UNDER

Application No. 48523 R-48522 Permit No. 36406 R-5892

IN NAME OF

A BAR L RANCH

Surveyed JUNE 23, 1975, by R. MUCKEN