


T.2N., R.10E., W.M.

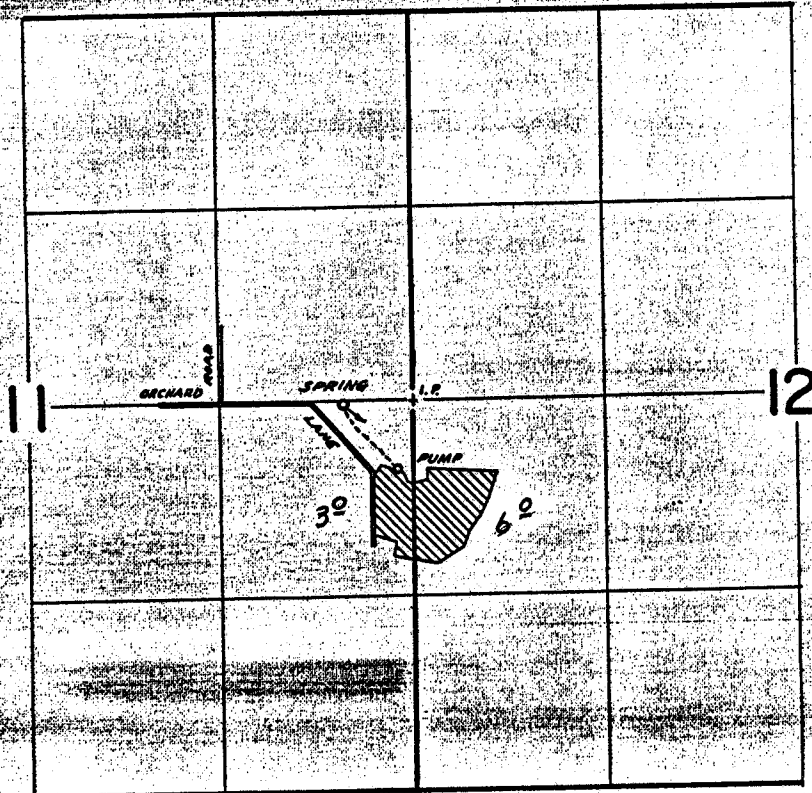

SPRING LOC: 20'S & 480' W FROM E 1/4 COR. SEC. 11.

FINAL PROOF SURVEY
UNDER

Application No. 49687 Permit No. 37199
IN NAME OF

DONALD E. AND JEANNETTE H. COPPER

Surveyed April 15 1975, by D. Norby