


T.33S.R.3E.W.M.

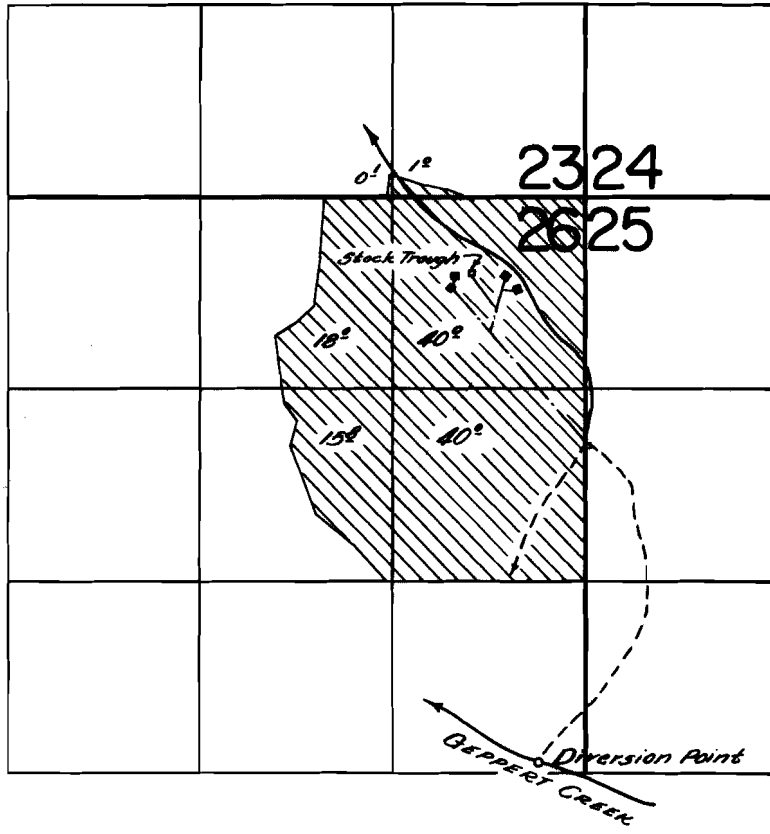

FINAL PROOF SURVEY
UNDER

Application No. 30292 Permit No. 23728
IN NAME OF

M.H. & Julia M. Pingle

Surveyed June 12, 1963, by C. Baker