


T. 35 S. R. 3 W. W.M.

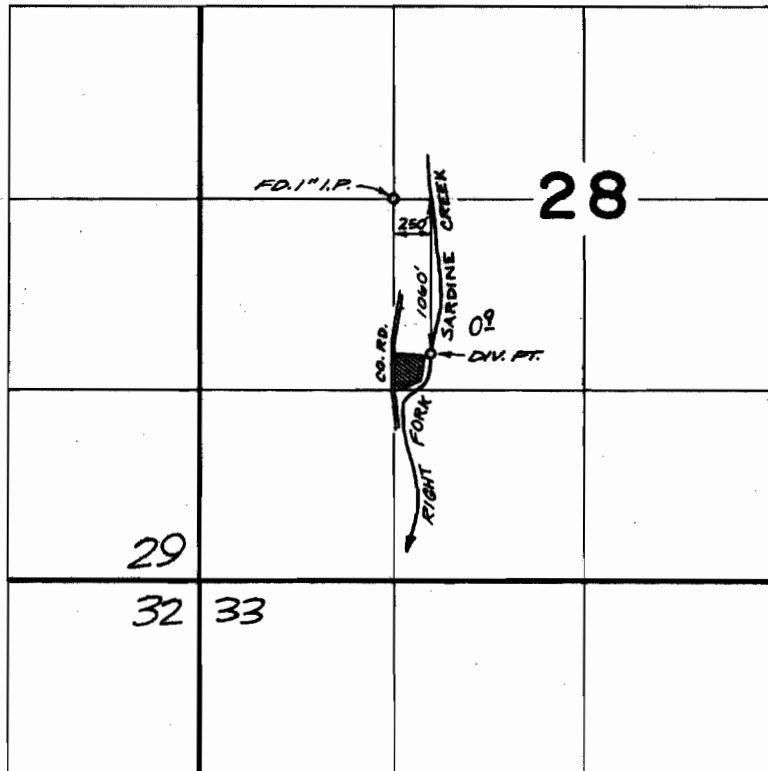

FINAL PROOF SURVEY
UNDER

Application No. ~~40980~~ Permit No. 35157
IN NAME OF

Mary J. Arnold

Surveyed JULY 29, 1974, by D. NORBY