


T. 37S. R. 5W.W.M.

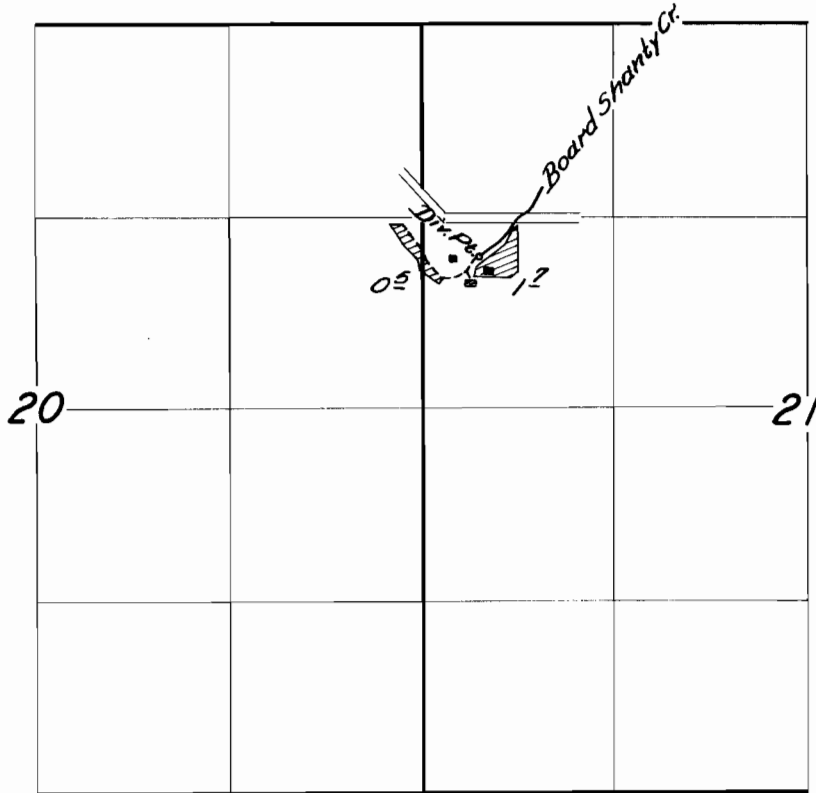

FINAL MAP OF SURVEY

UNDER


Application No. 26543 Serial No. 20800

IN NAME OF

Walter L. Brown

Surveyed July 20 19 59, by CB Bartlett

T.37S. R.5W.W.M.

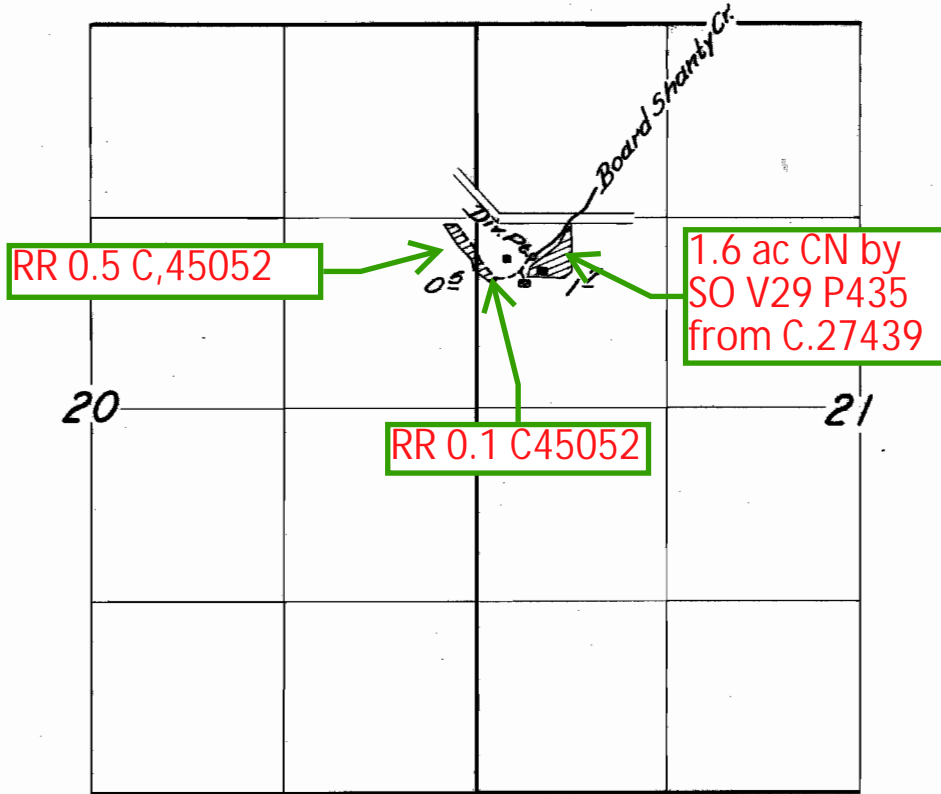

FINAL PROOF SURVEY

UNDER

Application No. 26543 Permit No. 20800

IN NAME OF

Walter L. Brown

Surveyed July 20 19 59, by C. B. Baitle