


T. 37S. R. 5W.W.M.

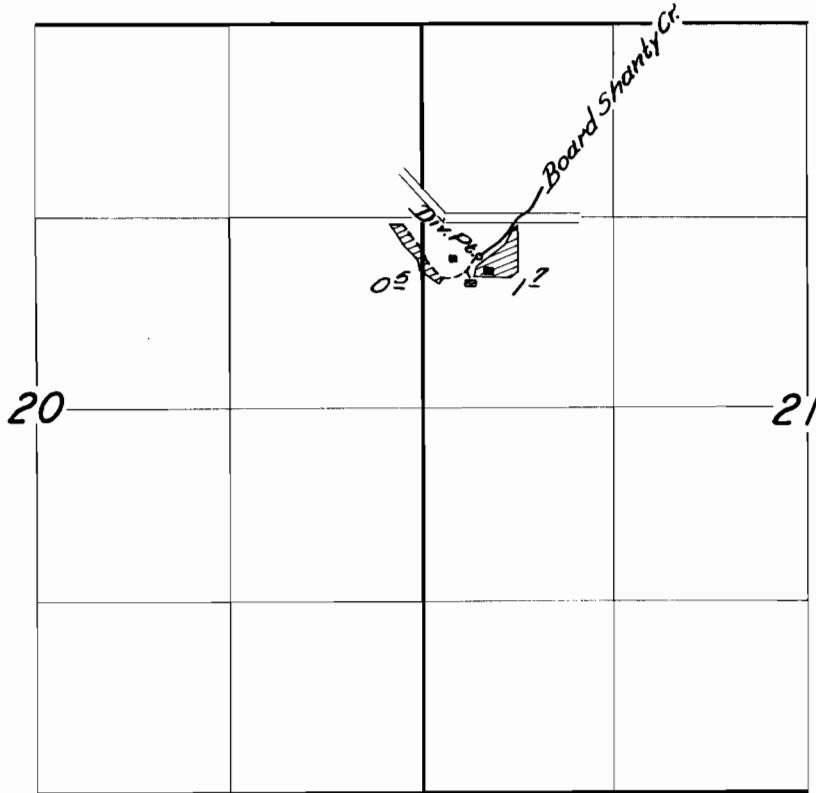

FINAL MAP OF SURVEY

UNDER

Application No. 26543 Serial No. 20800

IN NAME OF

Walter L. Brown

Surveyed July 20 19 59, by CB Bartlett