


T.38S.,R.5W.,W.M.

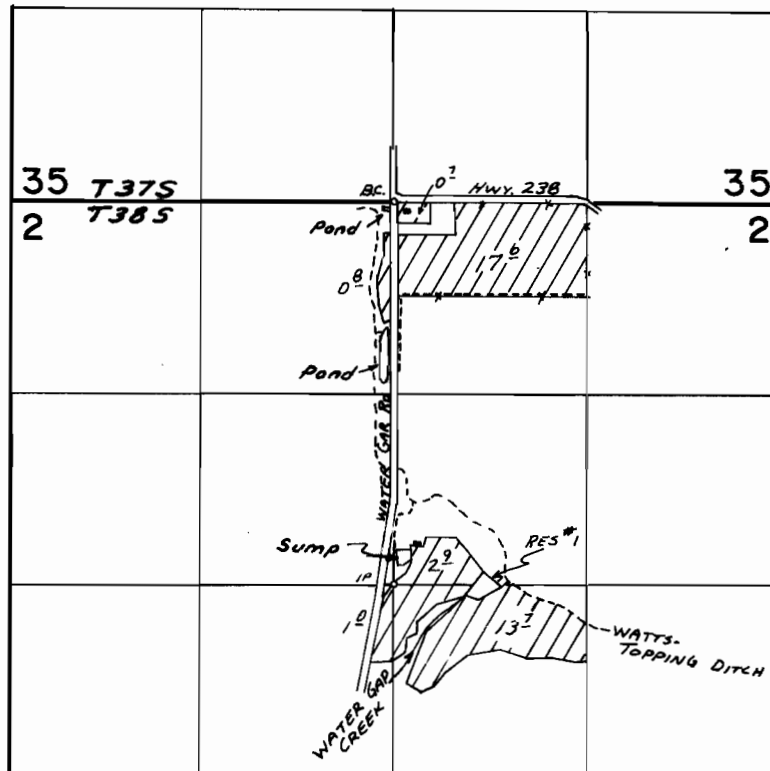

P.O.D.: 20' N & 700' E from the C¹/₄ cor. Section 2

FINAL PROOF SURVEY
UNDER

Application No. R-50283 Permit No. R-5970
50284 IN NAME OF

JOHN R. WOOD

Surveyed APRIL 29 1976, by L. TOLL