


# T.38S.,R.5W.,W.M.

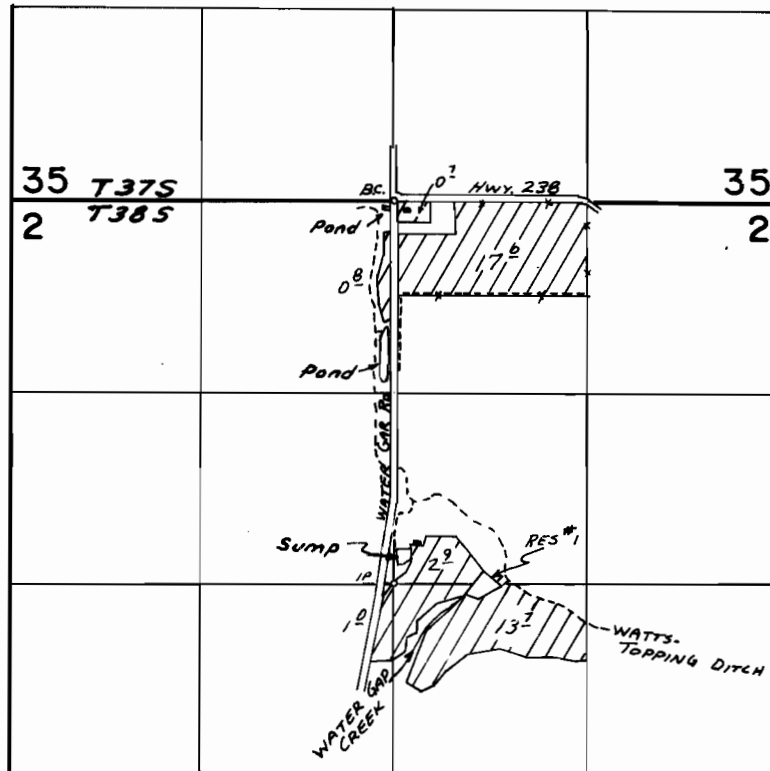

P.O.D.: 20' N & 700' E from the C<sup>1</sup>/<sub>4</sub> cor. Section 2

## FINAL PROOF SURVEY UNDER

Application No. 50283 Permit No. 36795  
IN NAME OF

JOHN R. WOOD

Surveyed APRIL 29 1976, by L. TOLL