


35869
45064
57555

T.39S. R.20E. W.M.

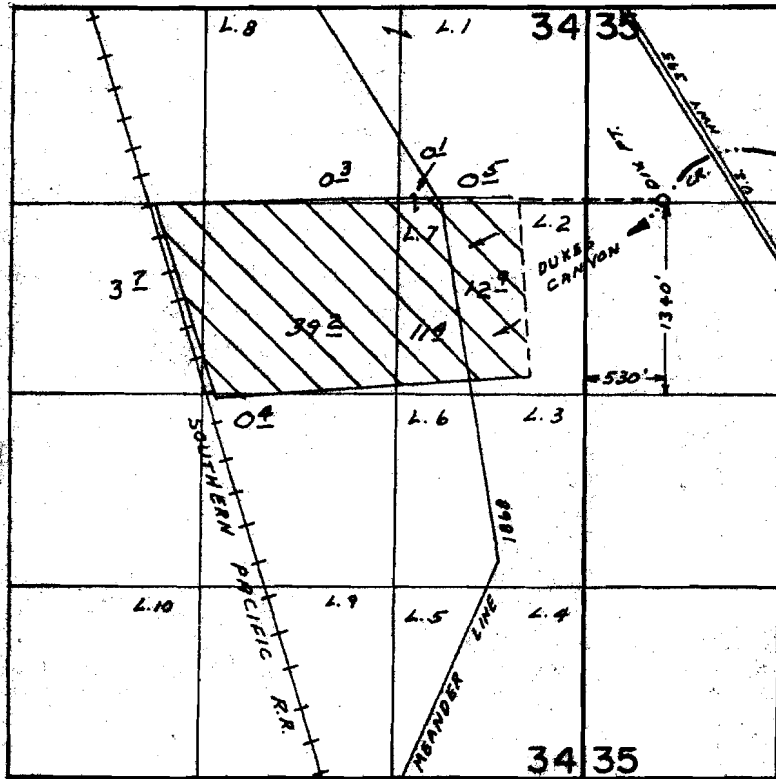

FINAL PROOF SURVEY UNDER

Application No. 47862... Permit No. 35869...
IN NAME OF

JOHN W. RICHARDSON

Surveyed JUL. 9. 1975, by L.H. NUNN