


# T.10S. R.9W. W.M.

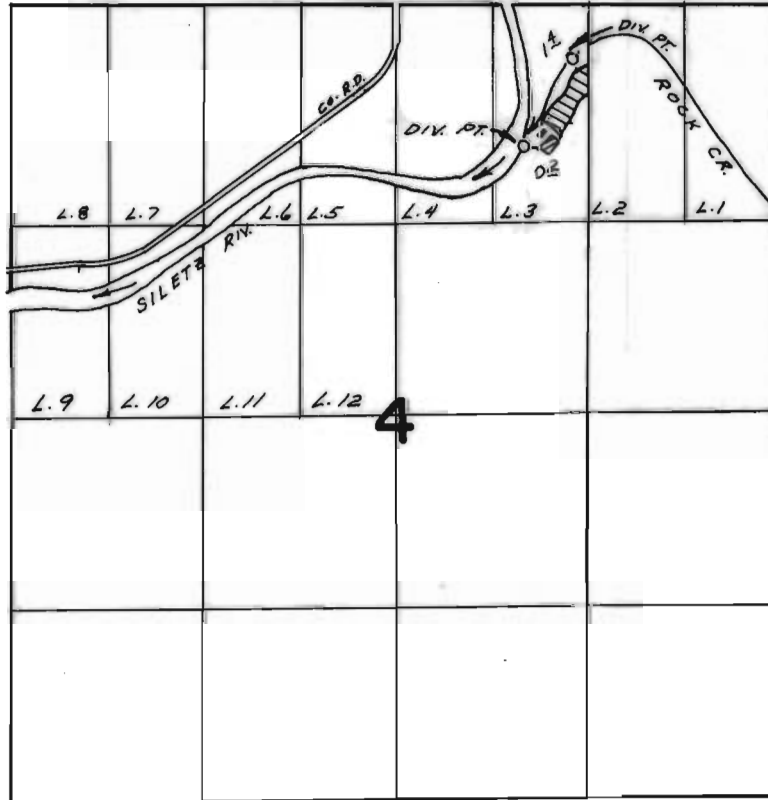

ROCK CR DIV: 980'S. & 1220'E.  
 SILETZ RIV. DIV: 980'S. & 890'E } BOTH FROM N. 1/4 COR. SEC. 4

## FINAL PROOF SURVEY UNDER

Application No. 48763... Permit No. 35966...  
 IN NAME OF

JOSEPH W. & MAXINE A. DAY

Surveyed OCT. 8, 1975, by L.H. NUNN