


T.14S., R.1W., W.M.

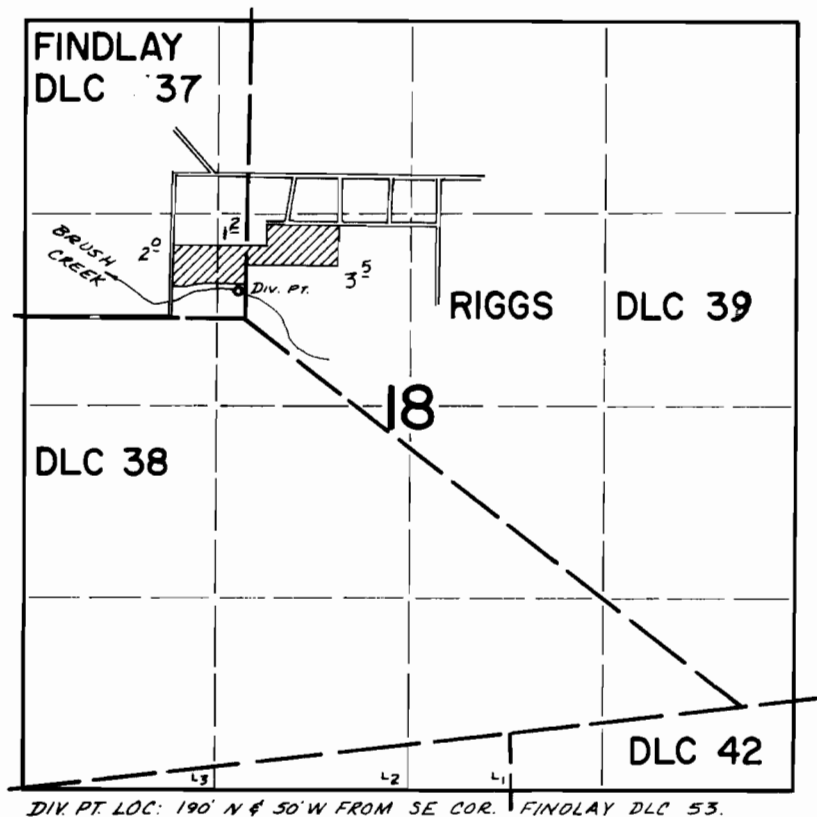

FINAL PROOF SURVEY
UNDER

Application No. 46834 Permit No. 35022
IN NAME OF

ALBERT AND VIRGINIA SCHUSTER

Surveyed Sept. 5 1975, by D. Norby