


T. 10 S. R. 1 E. W. M.

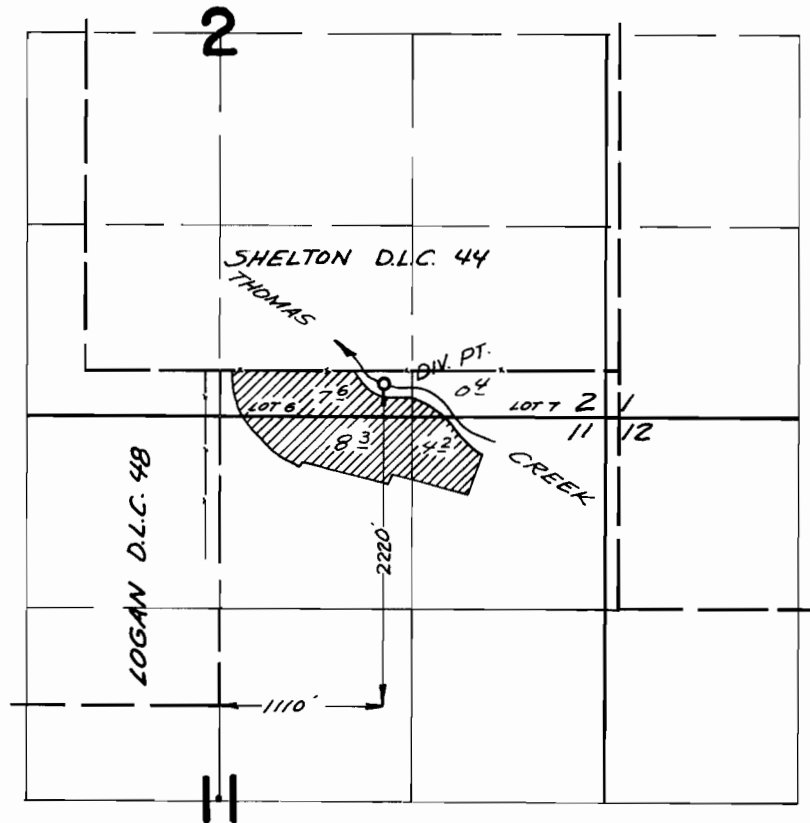

FINAL PROOF SURVEY UNDER

Application No. 42351 Permit No. 31687
IN NAME OF

LEO and ANNA VOLTIN

Surveyed Sept 26 1968, by V. Garner