


T.31S., R.41&42E., W.M.

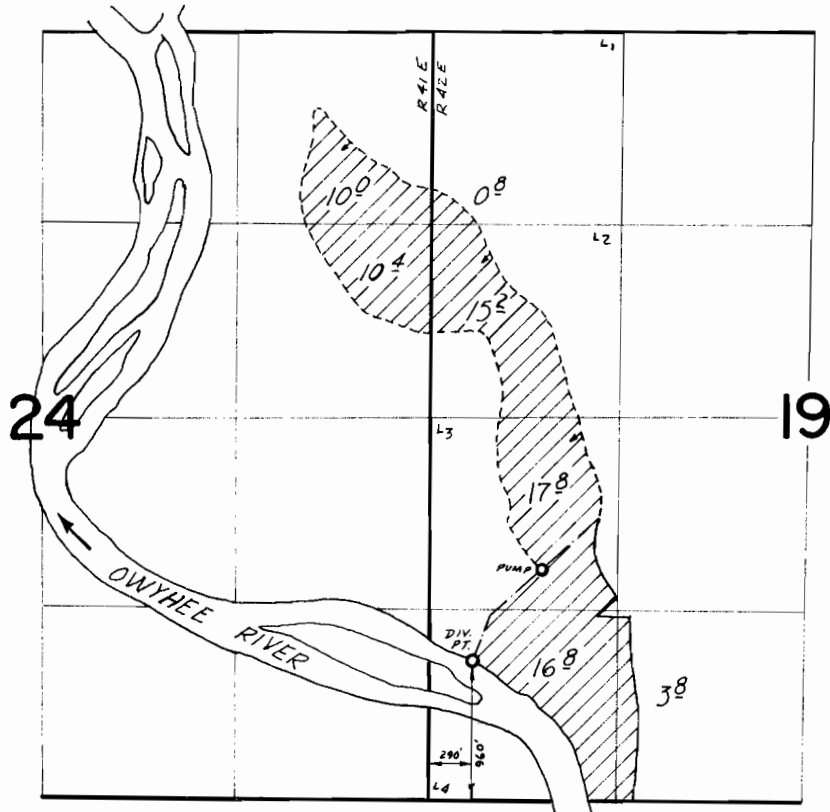

**FINAL PROOF SURVEY**  
UNDER

Application No. 43315 Permit No. 31700  
IN NAME OF  
ARELGOLD, INC.

Surveyed July 14 1975, by D. Norby