


T.5S. R.2W. W.M.

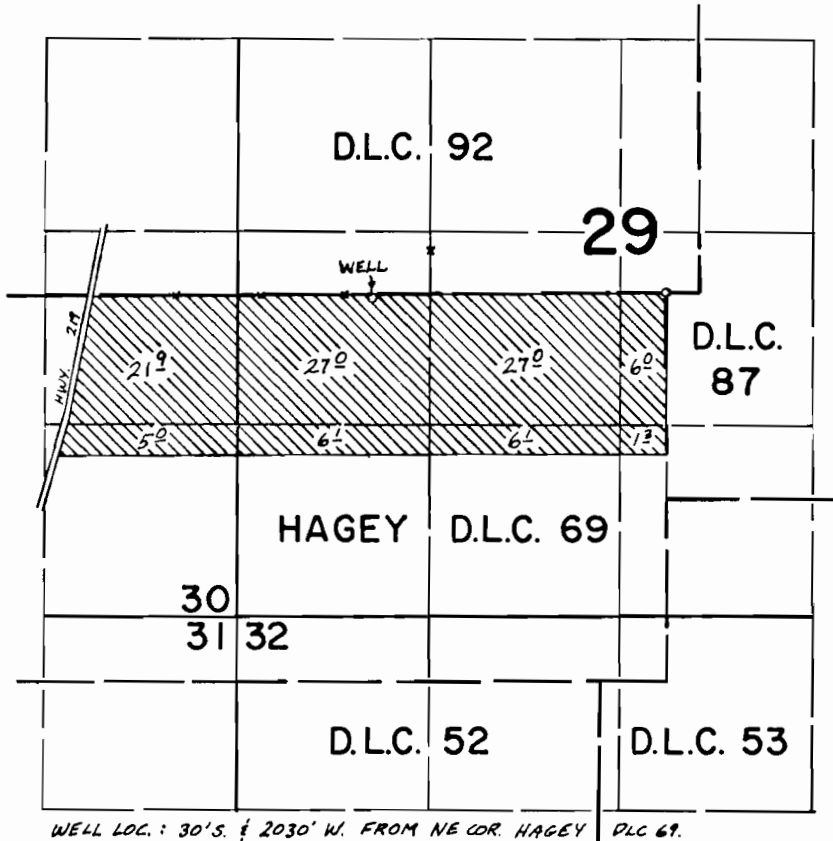

FINAL PROOF SURVEY UNDER

Application No. G-5975 Permit No. G-5187
IN NAME OF

EDWARD D. GRASSMAN

Surveyed MAY 27 1975, by L. H. NUNN